

Pearl R.
C-16
7-61

MISSISSIPPI BOARD OF WATER COMMISSIONERS

WATER WELL DRILLERS LOG

Date: July, 1961, Driller: Leo Fisher
(Name)

CODED

<p>(1) Owner of Land: <u>Leo Fisher</u> (Name) <u>25 Sunbelt</u> (Address)</p>	<p>Description & Color of Materials Sand, Clay, Red Clay, Shell, etc. <u>Light Blue Clay</u> <u>Sand + shells off ground</u></p>	<p>Thick- ness Feet <u>7</u></p> <p>Depth Feet <u>2-7</u> <u>39</u> <u>7-4</u></p>
<p>(2) Location: <u>1/4</u>, <u>1/4</u>, Sec. <u>33</u> <u>T14R15</u> <u>3</u> miles <u>West</u>, of <u>Sunbelt</u> (distance) (direction) (Nearest Town)</p>		
<p>(3) Topography: <input checked="" type="checkbox"/> (Hilly) <input type="checkbox"/> (Flat) <input type="checkbox"/> (Level)</p>		
<p>(4) Purpose of Well: <u>None</u> (Domestic Irrigation Municipal, Industrial, Other)</p>		

Information upon completion of well:


- (1) Diameter 4 inches.
- (2) Total Depth 46 feet.
- (3) Water Level 30 feet below top of ground.
- (4) Cased to 46, Size 4"
- (5) Screen: Size 20, Length 6 ft
- (6) Were any formations sealed against pollution?
 yes, no.

If YES depth of formation _____

Why _____

Drillers Remarks: _____

CODED

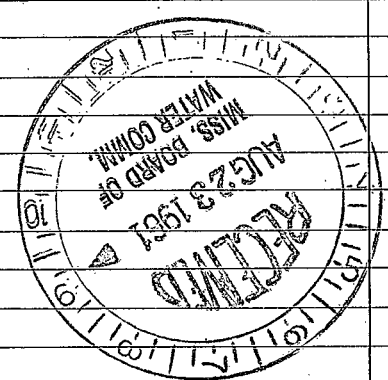

(Use Back Side)

Well No. 46

