

Pearl R.

MISSISSIPPI BOARD OF WATER COMMISSIONERS

C-17

WATER WELL DRILLERS LOG

**CODED**

8-4-61

Date: Aug 4, 1961

Driller: Geo. Jones

County: Washington

(Name)

(1) Owner of Land: James O. Bell

(Name)

B#2 Lumberton Miss.

(Address)

Description & Color of Materials  
Sand, Clay, Red Clay, Shell, etc.

Thick-  
ness  
Feet

Depth  
Feet

Surface soil 3 0-3  
Red sand & gravel 27 3-30

(2) Location: 1/4, 1/4, Sec. 33 N R 15

3 miles West of Lumberton  
(distance) (direction) (Nearest Town)

(3) Topography: Flat

(Hilly) (Flat) (Level)

(4) Purpose of Well: Home Use

(Domestic Irrigation  
Municipal, Industrial, Other)

Information upon completion of well:

(1) Diameter 4 inches.

(2) Total Depth 30 feet.

(3) Water Level 16 feet below top of ground.

(4) Cased to 30, Size 4"

(5) Screen: Size .040, Length 5 ft.

(6) Were any formations sealed against pollution?


yes, no.

If YES depth of formation \_\_\_\_\_

Why \_\_\_\_\_

Drillers Remarks: \_\_\_\_\_

**CODED**

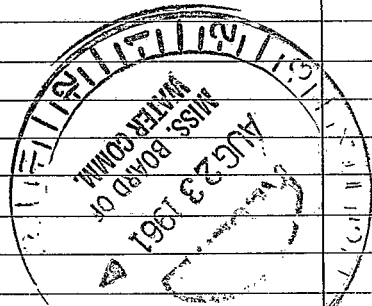

(Use Back Side)

Well No.

