

Pearl R.

C-18

4-27-62

WATER WELL DRILLERS LOG

Date: 7-27, 1962, Driller: Leo Sedner

2340

(Name)

CODED

(1) Owner of Land: Clifford Byrd

(Name)

Lumberton Miss

(Address)

Description & Color of Materials
Sand, Clay, Red Clay, Shell, etc.

Thick-
ness
Feet

Depth
Feet

Clay
Sand + Shale 19 0-19
28 19-47

(2) Location: 1/4, 1/4, Sec. 33 T14 N R 15 E

3 miles West of Lumberton

(distance) (direction) (Nearest Town)

(3) Topography: 2

(Hilly) (Flat) (Level)

(4) Purpose of Well: Home use

(Domestic Irrigation
Municipal, Industrial, Other)

CODED

Information upon completion of well:

(1) Diameter 2 inches.

(2) Total Depth 47 feet.

(3) Water Level 35 feet below top of ground.

(4) Cased to 42, Size 2"

(5) Screen: Size 1/2, Length 5'


(6) Were any formations sealed against pollution?

no

If YES depth of formation _____

Why _____

Drillers Remarks: _____

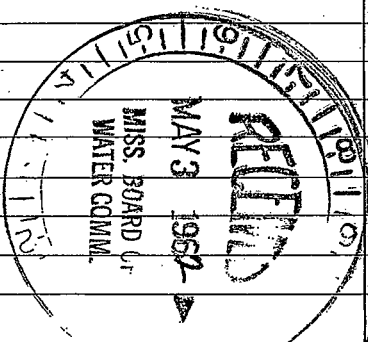

(Use Back Side)

Well No. 69

