

P.R.
C 54
12-17-74

MISSISSIPPI
BOARD OF WATER COMMISSIONERS
416 North State Street
Jackson, Mississippi 39201

COPIED

WATER WELL DRILLERS LOG

12-17 1974 Lumpha Well Co. Paul Riner
date well completed firm name county well located

LANDOWNER: <u>Buddy Moody</u>	description of formations encountered	from	to
<u>P.O. Box Poplarville Miss</u> (mailing address)	<u>Clay</u>	<u>0</u>	<u>45</u>
	<u>Sand</u>	<u>45</u>	<u>60</u>
WELL LOCATION:			
sec <u>19</u> T <u>1</u> N R <u>15</u> E			
<u>8</u> miles <u>North</u> of <u>Poplarville</u>			
(distance) (direction) (nearest town)			
WELL PURPOSE: <u>Home</u> (home, irrigation, municipal, industrial)			
WELL COMPLETION DATA:			
(1) diameter (inches) <u>2"</u>			
(2) total depth (feet) <u>60'</u>			
(3) static water level (feet) <u>52'</u> below top of ground.			
(4) casing <u>P.V.C.</u> , <u>55'</u> (material) (depth)			
<u>2"</u> if telescope see back. (size)			
(5) screen <u>5'</u> , <u>55'</u> (length) (depth to top)			
<u>2"</u> , <u>P.V.C.</u> (size) (material)			
(6) pump <u>1/2</u> , <u>400 g.p.m.</u> (HP) (yield gpm)			
<u>Electric</u> (type power)			
(7) electric log <u>No</u> (yes or no)			
(organization running log)			
(8) how well bottom plugged <u>Sand Shrub</u>			
DRILLERS REMARKS:			
JAN 22 1975			
MISS. RD. OF WATER COMM.			


COPIED

RECEIVED

Well No. 10

If well telescopes please sketch and show depths.

GROUND LEVEL

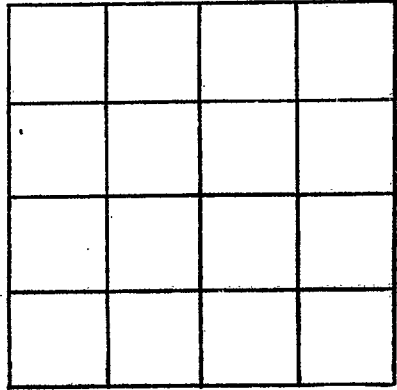

SECTION _____

Please indicate well location X.

ADDITIONAL INFORMATION

If more than one screen, show locations of each on sketch.