

PEARL RIVER
C-56
4-13-80

MISSISSIPPI
BOARD OF WATER COMMISSIONERS
416 North State Street
Jackson, Mississippi 39201

CODED

WATER WELL DRILLERS LOG

4-12 19 80 Dixie Water Wells Pumping Pearl River
date well completed firm name county well located

LANDOWNER: TOMMY SMITH

RTI Poplarville Ms.

(mailing address)

WELL LOCATION:

sec. 15 T 1 N R 15 E
3 miles North of Ford Creek
(distance) (direction) (nearest town)

WELL PURPOSE: HOME
(home, irrigation, municipal, industrial)

WELL COMPLETION DATA:

- (1) diameter (inches) 4"
- (2) total depth (feet) 178'
- (3) static water level (feet) 30' below top of ground.
- (4) casing PVC 158' (material) (depth)
4" (size) If telescope see back.
- (5) screen 20' 178' (length) (depth to top)
4" PVC (size) (material)
- (6) pump 1 30 (HP) (yield gpm)
ELECTRIC (type power)
- (7) electric log NO (yes or no)

(organization running log)

(8) how well bottom plugged SAND SHANK

description of formations encountered

from to

White Sand	0	33
BROWN Clay	33	45'
BLUE Clay	45	73
FINE GRAY SAND	73	103
COARSE GRAY SAND	103	178

CODED

DEPT. OF NATURAL RESOURCES
BUREAU OF LAND & WATER RESOURCES


APR 17 1980

RECEIVED

DRILLERS REMARKS:

If well telescopes please sketch and show depths.

GROUND LEVEL

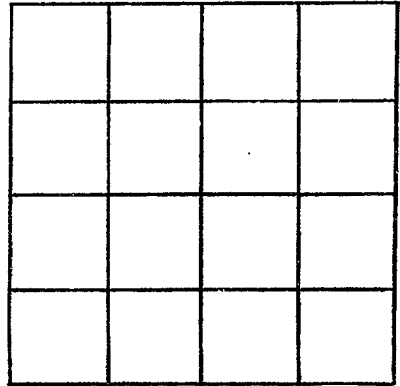

SECTION _____

Please indicate well location X.

ADDITIONAL INFORMATION

If more than one screen, show locations of each on sketch.