

MISSISSIPPI DEPARTMENT OF NATURAL RESOURCES

Bureau of Land and Water Resources

Southport Mall

P.O. Box 10631

Jackson, Mississippi 39209

WATER WELL DRILLERS LOG

CODED

Pearl River  
C 57  
4-22-85

4/22/85 date well completed  
Bradley Pump & Well Sew, Inc. firm name  
Pearl River county well located

LANDOWNER: Bobby Berger  
Rt. 1, Box 38 E  
Poplarville, Ms. 39490  
(mailing address)

description of formations encountered

from to

Clay + sand	0	80
white clay	80	160
blue clay	160	200
sand	200	240

WELL LOCATION:

sec. 31 T. 1 N. R. 15 E. S. 4 W.  
4 miles N of Poplarville  
(distance) (direction) (nearest town)

WELL PURPOSE: Home  
(home, irrigation, municipal, industrial)

WELL COMPLETION DATA:

- (1) diameter (inches) 2"
- (2) total depth (feet) 240
- (3) static water level (feet) 100 below top of ground.
- (4) casing PVC 225  
(material) (depth)
- 2" If telescope see back.  
(size)
- (5) screen 10' 225  
(length) (depth to top)
- 2" PVC  
(size) (material)
- (6) pump 1 5  
(HP) (yield gpm)
- 230V Ø  
(type power)
- (7) electric log no  
(yes or no)

(organization running log)

(8) how well bottom plugged PVC sandshank

DRILLERS REMARKS: 5'


tail pipe

RECEIVED  
MAY 31 1985

Department of Natural Resources  
Bureau of Land & Water Resources

If well telescopes please sketch and show depths.

GROUND LEVEL

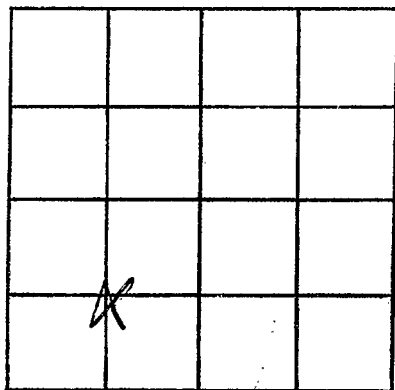

SECTION 31

Please indicate well location X.

ADDITIONAL INFORMATION

If more than one screen,  
show locations of each on sketch.