

FEB-5-2002 11:04P FROM:

TO:16013600535

P:1

County: Pearl River
 Parish #: _____
 Driller: Travis Boone
 Date drilling completed: 5-9-08

State Well Report
Part 1

Mississippi Department of Environmental Quality
 Office of Land and Water Resources
 P.O. Box 10631
 Jackson, MS 39289-0631
 (601)961-5210
 (601)354-6938 (fax)

For Office Use Only:
 Aquifer: _____
 Well #: C-81
 L. S. Elevation: _____
 B-log #: _____

State Law requires that this report be prepared by the driller in detail and filed with the Department within 30 days of completion of drilling of the well.

Well Owner Information		Well Location	
Owner Name: <u>Charles McLendon</u>	Latitude: _____ " Longitude: _____ "	Method of Lat/Long (circle one): <u>Conventional Survey</u>	
Mailing Address: <u>7 Radner Dr</u>		<u>USGS quad, Hand-held GPS, Survey-grade GPS</u>	
<u>Lumberton, ms</u>		<u>1/4 1/4 Sec 36 Twn 1S Rng 15W</u>	
City: _____ State: _____ Zip Code: <u>39455</u>	Distance: <u>5</u> Miles Direction: <u>S</u> of Nearest Town: <u>Lumberton</u>		
Telephone No. () _____			
Well Data			
Purpose of Well (circle one): <u>Home</u> Industrial Public Supply Irrigation Fish Culture Other: _____			
Date well drilling started: <u>5-9-08</u>		Date well drilling completed: <u>5-9-08</u>	
If flowing, method of flow regulation: Valve _____ Other (describe): _____			
Static Water Level: <u>40</u> feet above or below (circle one) land surface		Date measured: <u>5-9-08</u>	
Method of Measurement (circle one): <u>steel tape</u> electric tape air line other: <u>String Line</u>			
Hole depth: _____ Well depth: <u>85</u>		Well grouted to a depth of <u>10</u> feet	
Type of grout (circle one): <u>Cement</u> Bentonite Mix			
Casing length: _____ feet Casing diameter: <u>4</u> inches		Type of casing: <u>sch 40</u>	
Screen length: <u>20</u> feet Screen diameter: <u>4</u> inches		Type of screen: <u>sch 40</u>	
Screen slot size: <u>8</u> inches		Setting depth: From _____ feet to _____ feet	
Type of completion (circle all applicable): <u>Gravel packed</u> Underreamed Telescoped Open hole Natural Development			
Other (describe): _____			
Top of log pipe or reduction in casing: _____ feet. If telescoped or more than one screen, describe on back of page			
Logs run (circle all applicable): No log run Electric Gamma Ray Density Sonic Neutron Other: _____			
Name of organization running log(s): _____			
I certify that the well was drilled, constructed, and completed in accordance with all applicable requirements of the Mississippi Department of Environmental Quality and/or the Mississippi Department of Health regulations and state laws.			
Print Name of Water Well Contractor and License No. <u>Travis Boone 0-514</u>		Signature of Water Well Contractor: <u>Travis Boone</u>	

RECEIVED
 JUN 09 2008
 BY: OLWR

FEB-5-2002 11:04P FROM:


TD:16013600535

P:3

C-81

If well telescopes please sketch below and show depths.

Ground Level

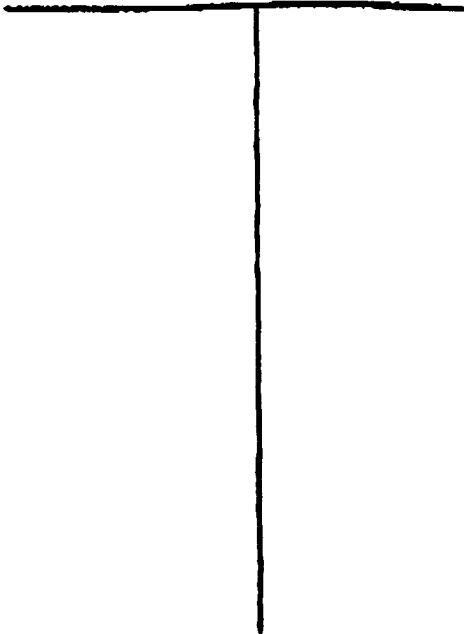

Description of Formation Encountered

Description of Formation Encountered	From	To
Sand + gravel	0	85

If more than one screen, show location of each on sketch

Sketch the property layout and include the following: 1) the well location; 2) any permanent structures on the property that may aid in locating the well; 3) any roads, power lines, or other lines that may aid in locating the property and the well; 4) indicate direction.

Landowner Name: Charles McClendon

Thomas Ross
 Signature of Water Well Contractor

RECEIVED
 JUN 09 2008
 BY: OLWR

FEB-5-2002 11:04P FROM:

TD:16013600535

P:2

STATE WELL REPORT

Part 2

Pump Installer's Completion Report
 Mississippi Department of Environmental Quality
 Office of Land and Water Resources
 P.O. Box 50831
 Jackson, MS 39205-0831
 (601)961-3210
 (801)354-0931 (fax)

Company: Parad River
 Permit #: _____
 Installer: Travis Boone
 Date completed: 5-9-08

Per Office Use Only
 Appt#: _____
 Well #: C-81
 Installer: _____

This report should be prepared by the pump installer to detail and filed with the Department within 30 days of the installation of pump.

Well Owner Information	Well Location
Owner Name: <u>Charles McLendon</u>	Latitude: _____ Longitude: _____
Mailing Address: <u>7 Lockner Dr.</u>	Method of Lat/Long (circle one): <u>Conventional Survey</u>
<u>Lumberton, MS</u>	USGS quad, Hand-held GPS, Survey-grade GPS
<u>39455</u>	_____ N _____ W Sec <u>36</u> Twp <u>1S</u> Rng <u>15W</u>
City State Zip Code	Distance Direction Nearest Town
Telephone No. (____) _____	<u>5</u> miles <u>S</u> of <u>Lumberton</u>

Pump Type Circle one	Power Type Circle one
Air Lift <input type="checkbox"/> Jet <input type="checkbox"/> <u>Submersible</u>	Diesel Engine <input type="checkbox"/> Gasoline Engine <input type="checkbox"/> Flashed Gas <input type="checkbox"/>
Booster <input type="checkbox"/> Piston <input type="checkbox"/> Turbine <input type="checkbox"/>	<u>Electric Motor</u> <input type="checkbox"/> Hand <input type="checkbox"/> Tractor PTO <input type="checkbox"/>
Centrifugal <input type="checkbox"/> Rotary <input type="checkbox"/> Floating Well <input type="checkbox"/>	Windmill <input type="checkbox"/> Other (specify): _____
Other (specify): _____	Motor Power Rating of Motor: <u>1</u>
Date Pump Installed: <u>5-9-08</u>	Setting Depth: <u>105</u> feet
Rated Pump Capacity: <u>12</u> Gallons Per Minute	Number of Stages: _____

Pump Test Data	Method of Measuring Water Level Circle one
Date Well Tested: <u>5-9-08</u>	Air Line <input type="checkbox"/> Electric Measuring Line <input type="checkbox"/> Steel Tape <input type="checkbox"/>
Static Water Level (A): <u>40</u> Feet Below Land Surface	Other (specify): <u>string line</u>
Pumping Water Level (B): _____ Feet Below Land Surface	For flowing well, measured static is least: _____ feet
Drawdown (D) - (A): _____ Feet Below Land Surface	Well yielded _____ GPM with a drawdown of _____ feet after _____ hours of pumping
Test Pumping Rate: <u>16.0E</u> Gallons Per Minute	
Duration of Pump Test (minimum 4 hours): _____ hours	

I HEREBY CERTIFY that the above statements are true to the best of my knowledge.

Travis Boone
 Print Name of Pump Installer and License No. (if applicable)

Travis Boone
 Signature of Pump Installer

RECEIVED
 JUN 09 2008
 BY: OLWR