
STATE WELL REPORT					
Doorl rivor		Part 1			
County: Pearl river	Driller's Log		For Office Use Only: Well #: <u>C91</u>		
Permit #:	Mississippi Department of Environmental Quality Office of Land and Water Resources				
Driller: Scott Boone	P.O. Box 2309		Aquifer:		
Date drilling completed:06/14/2021	Jackson, MS 39225-2309 (601)961-5555		E-Log #:		
(601)961-5228 (fax)					
State Law requires that this report be prepared by the license holder responsible for the work and filed with the Department at the above address within 30 days of completion of drilling of the well or borehole.					
Well Owner Information		Well or Bore	Well or Borehole Location		
(Landowner if borehole is not for a water well) Owner Name: Alice Lockhart		Latitude: 30.9780970 Longitude: -89.4526340			
Mailing Address: Dubose rd		Method of Lat/Long (check one): Conventional Survey,			
Mailing Address:		USGS quad, Hand-held GPS, Survey-grade GPS			
Lumberton Mississ	sipp 39455 SE 1/4 NW 1/4, Sec_		<u>12 _T 01S _R 15W</u>		
City State Zip Code 2 miles South of Lumberton					
			(Nearest Town)		
		orehole Data			
Date drilling started: 06/14/2021 Date drilling completed: 06/14/2021 Hole depth: 205 Hole diameter: 7-1/4 Location of the source of any surface water used for drilling: Well Method of dosing and volume of Chlorine used in drilling and development: Granular Logs run (check <i>all applicable</i>): No log run Electric Gamma Ray Density Sonic Neutron Other:					
Name of organization running log(s):					
Purpose of borehole (check one): Water Well 🗹 Geotechnical/Geological Investigation Ground Source Heat Pump					
Seismic Survey Other (<i>describe</i>)					
If drilling is not rel	ated to water well c	onstruction, skip the remainder	of this block		
Purpose of Well (check all applicable):	—		Fish Culture		
Other (describe):					
If a flowing well, method of flow regul					
Static Water Level: 90feet [above or 🖆 below] land surface Date measured: 06/14/2021					
Method of measurement (check one): Steel tape Electric tape Air line Other (describe):					
Well depth: 205 Well grouted to a depth of: 10 feet Type of grout (check one): Neat Cement Bentonite Mix					
Casing length: <u>185</u> feet Casing diameter: <u>4</u> inches Type of casing: <u>PVC</u>					
Screen length: <u>20</u> feet Screen diameter: <u>4</u> inches Type of screen: <u>Pvc</u>					
Screen slot size: 008inches Setting depth: From 185feet to 205feet					
Type of completion (check all applicable): Gravel packed 🗹 Underreamed Open hole Natural Development					
Other (describe):					
Top of lap pipe or reduction in casing:	feet		RECEIVED		
If telescoped or more than one screen, describe on next page 07-23-20					
-		· ·	Form: OLWR-SWR-1A (4/1		
			BY OLWR		

County:	Pearl river
Permit #:	

The sketch below only required for water wells





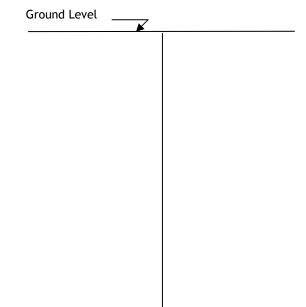

For Office Use Only: Well #: _____

Description of formations encountered must be provided for all wells and boreholes, unless specifically exempted by regulations

Description of Formations Encountered	From (<i>depth</i>)	To (depth)
Sandy orange clay	Ground level	15
White clay	15	80
Powder sand	80	105
Blue clay	105	168
Chorus sand	168	205

If more than one screen, show location of each on sketch



Landowner Name: Alice Lockhart

I HEREBY CERTIFY that the well/borehole was drilled, constructed, and completed in accordance with all applicable requirements of the Mississippi Department of Environmental Quality and the Mississippi Department of Health regulations, if applicable, and state laws.

Scott Boone 6262 07/19 Print Name of Responsible Licensee and License No.

07/19/2021 Date



Scott Boone Signature of Licensee

Form: OLWR-SWR-1B (4/13)