

PEARL River
 C-2000
 4-68

MISSISSIPPI
 BOARD OF WATER COMMISSIONERS
 416 North State Street
 Jackson, Mississippi 39201

WATER WELL DRILLERS LOG

4-18-1968 Leobudwar Pearl River
 date well completed firm name county well located

LANDOWNER: Heddie Byrd
RT 2
Lumberton MISS
 (mailing address)

description of formations encountered	from	to
<u>subsurface</u>	<u>0</u>	<u>1</u>
<u>Red clay</u>	<u>1</u>	<u>26</u>
<u>Sand</u>	<u>26</u>	<u>58</u>

WELL LOCATION:
 sec 33 T 1 N R 15 E
S W
2 miles W of Lumberton
 (distance) (direction) (nearest town)

WELL PURPOSE: Domestic
 (home, irrigation, municipal, industrial)

- WELL COMPLETION DATA:
- (1) diameter (inches) 2
 - (2) total depth (feet) 53
 - (3) static water level (feet) 38 below above top of ground.
 - (4) casing Pl. 48
 (material) (depth)
 (size) if telescope see back.
 - (5) screen 5' 48
 (length) (depth to top)
2 Pl.
 (size) (material)
 - (6) pump 1/2 8
 (HP) (yield gpm)
2HP
 (type power)
 - (7) electric log NO
 (yes or no)
 (organization running log)
 - (8) how well bottom plugged partially


DRILLERS REMARKS:

APR 15 1968

MISS. BO. OF WATER COMMISSIONERS

If well telescopes please sketch and show depths.

GROUND LEVEL

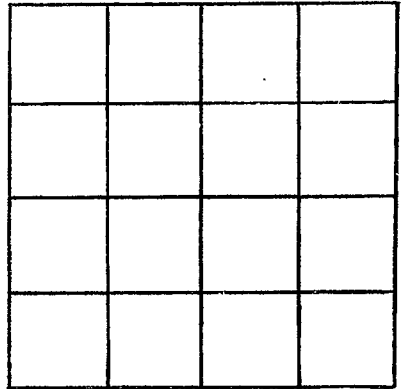

SECTION _____

Please indicate well location X.

ADDITIONAL INFORMATION

If more than one screen,
show locations of each on sketch.