

12

PEARL RIVER  
C 2001  
4-68

MISSISSIPPI  
BOARD OF WATER COMMISSIONERS  
416 North State Street  
Jackson, Mississippi 39201

WATER WELL DRILLERS LOG

4-18 1968 Leo Hadner Pearl River  
date well completed firm name county well located

LANDOWNER: Olive Baptist  
Church PARSONAGE  
Lumberton MISS  
(mailing address)

description of formations encountered	from	to
Surface	0	1
Red Clay	1	13
Red Sand	13	32
White Clay	32	94
Sand & Clay streak	94	123
Sand	123	157

WELL LOCATION:  
sec 33 T 1 N R 15 E  
S W  
2 miles W of Lumberton  
(distance) (direction) (nearest town)

WELL PURPOSE: Home  
(home, irrigation, municipal, industrial)

- WELL COMPLETION DATA:
- (1) diameter (inches) 2
  - (2) total depth (feet) 157
  - (3) static water level (feet) 106 below top of ground.
  - (4) casing Pl. 152 (material) (depth)  
2 (size) if telescope see back.
  - (5) screen 5 152 (length) (depth to top)  
2" (size) Pl (material)
  - (6) pump 1 6 (HP) (yield gpm)  
Elec (type power)
  - (7) electric log NO (yes or no)

(organization running log)


(8) how well bottom plugged Sw make

DRILLERS REMARKS:

1977 1968  
MISS. DEPT. OF  
WATER COMMISSIONERS

If well telescopes please sketch and show depths.

GROUND LEVEL

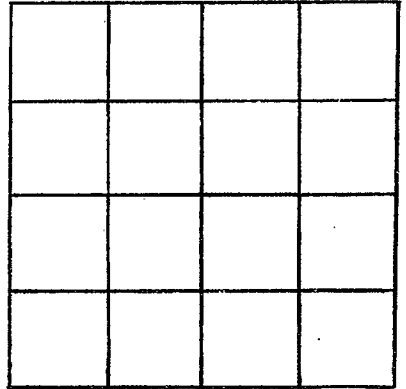

SECTION \_\_\_\_\_

Please indicate well location X.

ADDITIONAL INFORMATION

If more than one screen, show locations of each on sketch.