

PEARL River
C 2002
4-68

**MISSISSIPPI
BOARD OF WATER COMMISSIONERS**
416 North State Street
Jackson, Mississippi 39201

WATER WELL DRILLERS LOG

9-14-1968 date well completed Walter Lohm firm name Pearl River county well located

LANDOWNER:
Walter Lohm
Rt 3 Lumberton
(mailing address)

description of formations encountered	from	to
<u>Surface Clay</u>	<u>9-30</u>	<u>30-60</u>
<u>Soft Stravel</u>	<u>10-34</u>	

WELL LOCATION:
see 26 T N R E
6 miles S 19 15 W
(distance) (direction) (nearest town)

WELL PURPOSE: Home
(home, irrigation, municipal, industrial)

- WELL COMPLETION DATA:
- diameter (inches) 2"
 - total depth (feet) 84
 - static water level (feet) 43 below above top of ground.
 - casing 2 81
(material) (depth)
 - screen 3 81
(length) (depth to top)
 - pump 1/2 8
(HP) (yield gpm)
- (size) if telescope see back.
- (size) (material)
- (type power)
- (7) electric log NO
(yes or no)
- (organization running log)
- (8) how well bottom plugged Plugged


DRILLERS REMARKS:

WELL 75 1968

MISS. BD. OF
WATER COMM.

If well telescopes please sketch and show depths.

GROUND LEVEL

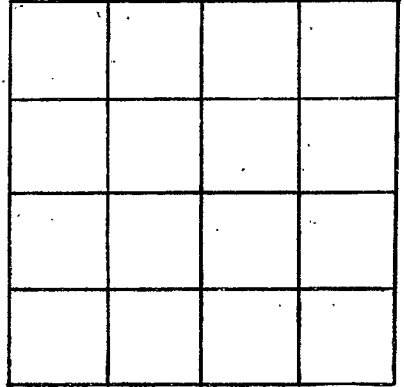

SECTION _____

Please indicate well location X.

ADDITIONAL INFORMATION

If more than one screen, show locations of each on sketch.