

PEARL RIVER
C 2004
12-8-76

MISSISSIPPI
 BOARD OF WATER COMMISSIONERS
 416 North State Street
 188 Jackson, Mississippi 39201

WATER WELL DRILLERS LOG

12-8- 1976 Sumphin Well Service Pearl River
 date well completed firm name county well located


LANDOWNER:	description of formations encountered	from	to
<u>International Paper</u>	<u>Clay</u>	<u>0</u>	<u>15</u>
<u>Company P.O. Box</u>	<u>Sand</u>	<u>15</u>	<u>55</u>
<u>Perkins (mailing address) 167</u>	<u>Clay</u>	<u>55</u>	<u>95</u>
<u>Miss. 39573</u>	<u>Sand</u>	<u>95</u>	<u>160</u>
WELL LOCATION:	<u>Clay</u>	<u>160</u>	<u>175</u>
sec. <u>29</u> T <u>1</u> N R. <u>15</u> E	<u>Sand</u>	<u>175</u>	<u>240</u>
(S) (W)	<u>Clay</u>	<u>240</u>	<u>300</u>
<u>7</u> miles <u>N</u> of <u>Poplarville</u>	<u>Sand</u>	<u>300</u>	<u>337</u>
(distance) (direction) (nearest town)			
WELL PURPOSE: <u>Industrial</u>			
(home, irrigation, municipal, industrial)			
WELL COMPLETION DATA:			
(1) diameter (inches) <u>2"</u>			
(2) total depth (feet) <u>337'</u>			
(3) static water level (feet) <u>125</u> ^{below} _{above} top of ground.			
(4) casing <u>P.V.C. 331'</u>			
(material) (depth)			
<u>2"</u> if telescope see back.			
(size)			
(5) screen <u>6'</u> <u>331'</u>			
(length) (depth to top)			
<u>2"</u> <u>P.V.C.</u>			
(size) (material)			
(6) pump <u>1 1/2</u> <u>390 G.P.H.</u>			
(HP) (yield gpm)			
<u>Electric</u>			
(type power)			
(7) electric log <u>NO</u>			
(yes or no)			
(organization running log)			
(8) how well bottom plugged <u>Sand</u>			
<u>Shard</u>			
DRILLERS REMARKS:			

RECEIVED
 JAN 24 1977

BOARD OF WATER COMMISSIONERS

If well telescopes please sketch and show depths.

GROUND LEVEL

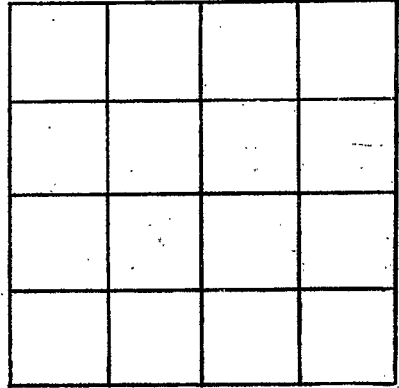

SECTION _____

Please indicate well location X.

ADDITIONAL INFORMATION

If more than one screen, show locations of each on sketch.