

Pearl River
 C
 2005
 10-1-77
 10-1

MISSISSIPPI
 BOARD OF WATER COMMISSIONERS
 416 North State Street
 Jackson, Mississippi 39201

WATER WELL DRILLERS LOG

1979 Pernell Anderson Pearl River
 firm name county well located

LANDOWNER:
Jernell Eaton
 (mailing address)
 WELL LOCATION:
 sec. 12 T. 1 R. 15
3 miles S of Sumberton
 (distance) (direction) (nearest town)

description of formations encountered	from	to
<u>Top Soil</u>	<u>0</u>	<u>2</u>
<u>Red Sand</u>	<u>2</u>	<u>20</u>
<u>White Clay</u>	<u>20</u>	<u>38</u>
<u>Course Sand</u>	<u>38</u>	<u>65</u>

WELL PURPOSE: HOME
 (home, irrigation, municipal, industrial)

WELL COMPLETION DATA:
 (1) diameter (inches) 2"
 (2) total depth (feet) 65'
 (3) static water level (feet) 43 below top of ground.
 (4) casing Plastic, 60'
 (material) (depth)
 (size) If telescope see back.
 (5) screen 5', 60'
 (length) (depth to top)
2", Plastic
 (size) (material)
 (6) pump 1, 9
 (HP) (yield gpm)
Elect
 (type power)
 (7) electric log NO
 (yes or no)
 (organization running log)

(8) how well bottom plugged
Capped
 DRILLERS REMARKS:


DEPT. OF NATURAL RESOURCES
 BUREAU OF LAND & WATER RESOURCES

NOV 20 1979

RECEIVED

If well telescopes please sketch and show depths.

GROUND LEVEL

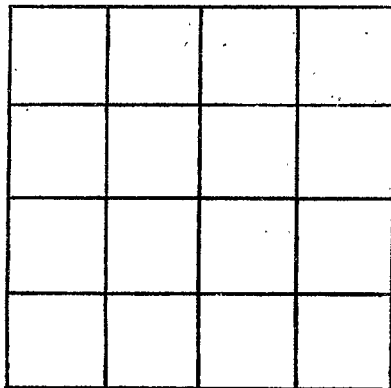

SECTION _____

Please indicate well location X.

ADDITIONAL INFORMATION

If more than one screen, show locations of each on sketch.