

PEARL RIVER
C 2000

MISSISSIPPI
 BOARD OF WATER COMMISSIONERS
 416 North State Street
 Jackson, Mississippi 39201

WATER WELL DRILLERS LOG

date well completed 19 1980 Dixie Water Well firm name Pearl River county well located

LANDOWNER: JOE LaBella
PO BOX 30
Belle Chasse La.
 (mailing address)

description of formations encountered	from	to
	<u>PINK SAND</u>	<u>0</u>
<u>PINK CLAY</u>	<u>30</u>	<u>40</u>
<u>White SAND (MED)</u>	<u>40</u>	<u>80</u>
<u>White Coarse SAND</u>	<u>80</u>	<u>160</u>

WELL LOCATION:
 sec. 25 T 1 N R 15 E
5 miles EAST of Hillsdale
 (distance) (direction) (nearest town)

WELL PURPOSE: HOME
 (home, irrigation, municipal, industrial)

WELL COMPLETION DATA:

- diameter (inches) 4"
- total depth (feet) 160'
- static water level (feet) 40 below above top of ground.
- casing PVC 140'
 (material) (depth)
4"
 (size) if telescope see back.
- screen 20' 160'
 (length) (depth to top)
4 PVC
 (size) (material)
- pump 1/2 15
 (HP) (yield gpm)
elect
 (type power)
- electric log NO
 (yes or no)

(organization running log)

(8) how well bottom plugged
SAND SHANK

DRILLERS REMARKS:


DEPT. OF NATURAL RESOURCES
 BUREAU OF LAND & WATER RESOURCES

APR 17 1980

RECEIVED

If well telescopes please sketch and show depths.

GROUND LEVEL

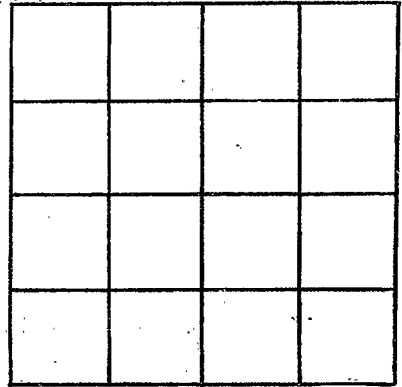

SECTION _____

Please indicate well location X.

ADDITIONAL INFORMATION

If more than one screen, show locations of each on sketch.