

MISSISSIPPI DEPARTMENT OF NATURAL RESOURCES

Bureau of Land and Water Resources

Southport Mall

P.O. Box 10631

Jackson, Mississippi 39209

WATER WELL DRILLERS LOG

Pearl River
C 2008
11-21-81

11/21/81 19 BRADEN Pump & Well Service, Inc. - Pearl River
date well completed firm name county well located

Butch LAIRD
LANDOWNER: Rt 4 Box 218
Poplarville, MS. 39470
(mailing address)

description of formations encountered	from	to
CLAY	0	10
SAND	10	40

WELL LOCATION: HILDALE Rd.
sec. 28 T. 1 N. R. 15 E
Hillsdale
miles (distance) of (nearest town)

WELL PURPOSE: HOME
(home, irrigation, municipal, industrial)

- WELL COMPLETION DATA:
- (1) diameter (inches) 2"
 - (2) total depth (feet) 40'
 - (3) static water level (feet) 20 below above top of ground.
 - (4) casing PVC total (material), (depth)
2" (size) if telescope see back.
 - (5) screen 10' (length), 30' (depth to top)
2" (size), PVC (material)
 - (6) pump 1-(20g) (HP), 14 (yield gpm)
230V-1Ø (type power)
 - (7) electric log No (yes or no)
- (organization running log)

(8) how well bottom plugged
SAND SHANK


DRILLERS REMARKS:
5 ft. tail pipe

DEPT. OF NATURAL RESOURCES
BUREAU OF LAND & WATER RESOURCES

DEC 10 1981
RECEIVED

If well telescopes please sketch and show depths.

GROUND LEVEL

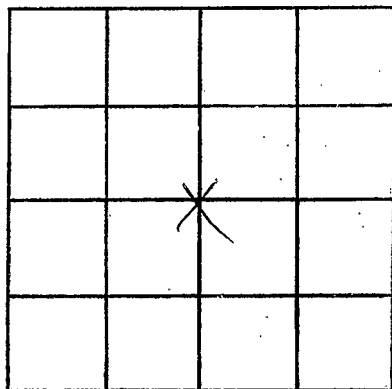

SECTION 28

Please indicate well location X.

ADDITIONAL INFORMATION

If more than one screen,
show locations of each on sketch.