

Pearl River
2009

MISSISSIPPI DEPARTMENT OF NATURAL RESOURCES
 Bureau of Land and Water Resources
 Southport Mall
 P.O. Box 10631
 Jackson, Mississippi 39209
WATER WELL DRILLERS LOG

11-14- 1982 BRADEN PUMP & Well Service, Pearl River
 date well completed firm name county well located

LANDOWNER:
Dennis Allen
1205 FRONT ST.
BOGALUSA (mailing address) LA.
 WELL LOCATION: 70427
 sec. 32 T-1 R-15
4 miles N of Ogdenville
 (distance) (direction) (nearest town)

description of formations encountered	from	to
SAND	0	20
CLAY	20	30
CLAY	30	40
CLAY	40	50
SAND	50	55
SAND	55	65
CLAY	65	80

WELL PURPOSE: HOME
 (home, irrigation, municipal, industrial)

WELL COMPLETION DATA:

(1) diameter (inches) 2"

(2) total depth (feet) 80'

(3) static water level (feet) 50 below top of ground.

(4) casing PVC 70'
 (material) (depth)
 (size) if telescope see back.

(5) screen SAT 70'
 (length) (depth to top)
2" PVC Underbar
 (size) (material)

(6) pump 3
 (HP) (yield gpm)
220V 1P
 (type power)

(7) electric log NO
 (yes or no)
 (organization running log)

(8) how well bottom plugged
PVC SAND SHARK

DRILLERS REMARKS:
5ft Tail pipe


DEPT. OF NATURAL RESOURCES
 BUREAU OF LAND & WATER RESOURCES

JAN 18 1983

RECEIVED

If well telescopes please sketch and show depths.

GROUND LEVEL

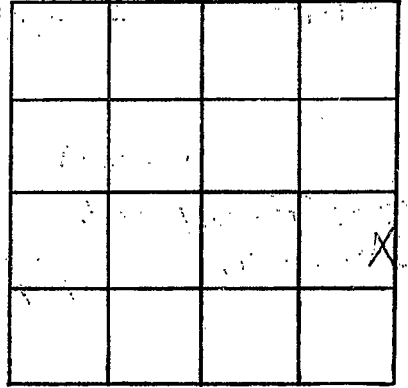

SECTION 3

Please indicate well location X.

ADDITIONAL INFORMATION

If more than one screen,
show locations of each on sketch.