

MISSISSIPPI DEPARTMENT OF NATURAL RESOURCES

Bureau of Land and Water Resources

Southport Mall

P.O. Box 10631

Jackson, Mississippi 39209

WATER WELL DRILLERS LOG

Pearl River
C 2011

5-29 1983
date well completed

Frank Paris
firm name

Pearl River
county well located

LANDOWNER:	description of formations encountered	from	to
Archie Diebold	Top Soil	0	3
(mailing address)	Clay	3	95
WELL LOCATION:	Shale Sand	95	135
sec 25 T 1 R 15 Lake Hillsdale Estate	Course Sand	135	140
(distance) (direction) (nearest town)			
WELL PURPOSE: HOME (home, irrigation, municipal, industrial)			
WELL COMPLETION DATA:			
(1) diameter (inches) 2			
(2) total depth (feet) 143'			
(3) static water level (feet) 18' below top of ground.			
(4) casing Plastic, 138' (material) (depth)			
if telescope see back. (size)			
(5) screen 5' , 138' (length) (depth to top)			
2, Plastic (size) (material)			
(6) pump 1 10 (HP) (yield gpm)			
Elect (type power)			
(7) electric log no (yes or no)			
(organization running log)			
(8) how well bottom plugged Backwash valve			

DEPT. OF NATURAL RESOURCES
BUREAU OF LAND & WATER RESOURCES


APR 18 1983

RECEIVED

DRILLERS REMARKS:

If well telescopes please sketch and show depths.

GROUND LEVEL

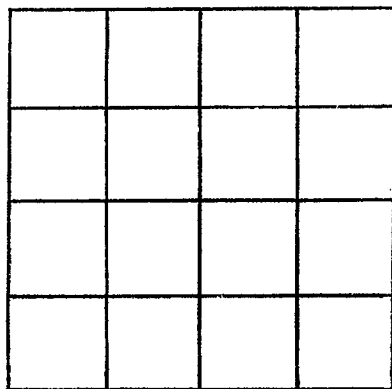

SECTION _____

Please indicate well location X.

ADDITIONAL INFORMATION

If more than one screen,
show locations of each on sketch.