

MISSISSIPPI DEPARTMENT OF NATURAL RESOURCES

Bureau of Land and Water Resources

Southport Mall

P.O. Box 10631

Jackson, Mississippi 39209

WATER WELL DRILLERS LOG

PEARL RIVER
C 2012

3/21/85 19 Lyman Well Co. Pearl River
date well completed firm name county well located

LANDOWNER: William Turner
Rt. 4, Box 287
Poplarville, MS 39470
(mailing address)

description of formations encountered	from	to
<u>Red sand</u>	<u>0</u>	<u>20</u>
<u>Red clay</u>	<u>20</u>	<u>40</u>
<u>Coarse sand</u>	<u>40</u>	<u>68</u>

WELL LOCATION:
sec. 8 T. 8 N. R. 14 E. 7615
15 miles north of Poplarville
(distance) (direction) (nearest town)

WELL PURPOSE:
(home, irrigation, municipal, industrial)

WELL COMPLETION DATA:

- (1) diameter (inches) 2"
- (2) total depth (feet) 68'
- (3) static water level (feet) 50 below above top of ground.
- (4) casing PVC, 58'
(material) (depth)
2" If telescope see back.
(size)
- (5) screen 10', 58'
(length) (depth to top)
2", PVC
(size) (material)
- (6) pump N/A
(HP) (yield gpm)
(type power)
- (7) electric log No
(yes or no)
No
(organization running log)
- (8) how well bottom plugged sand
shark


DRILLERS REMARKS:

RECEIVED
AUG 20 1985

Department of Natural Resources
Bureau of Land & Water Resources

If well telescopes please sketch and show depths.

GROUND LEVEL

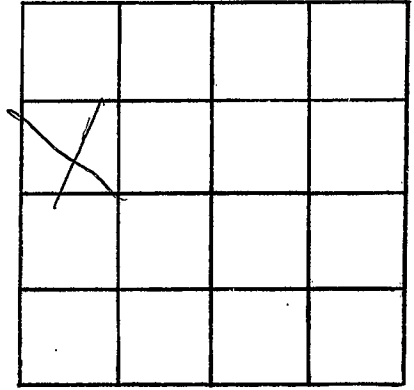

SECTION 6

Please indicate well location X.

ADDITIONAL INFORMATION

If more than one screen,
show locations of each on sketch.