

MISSISSIPPI DEPARTMENT OF NATURAL RESOURCES

Bureau of Land and Water Resources

Southport Mall

P.O. Box 10631

Jackson, Mississippi 39209

WATER WELL DRILLERS LOG

P. R. J. A.
C
2015


10/13/88 date well completed 1988 Bud Denton's Sons firm name Pearl River county well located

LANDOWNER: <u>Brooks Griffin</u>	description of formations encountered	from	to
<u>B.T. 3 Elgin ark</u>			
<u>12333</u> (mailing address)	<u>Red sand</u>	<u>42</u>	<u>90</u>

WELL LOCATION:
 sec. 27 T 1 N R 15 E
 S W
12 miles NE of Poplarville
 (distance) (direction) (nearest town)

WELL PURPOSE: none
 (home, irrigation, municipal, industrial)

- WELL COMPLETION DATA:
- (1) diameter (inches) 4"
 - (2) total depth (feet) 90
 - (3) static water level (feet) _____ below above top of ground.
 - (4) casing _____ (material) _____ (depth) _____ (size) if telescope see back.
 - (5) screen _____ (length) _____ (depth to top) _____ (size) _____ (material)
 - (6) pump _____ (HP) _____ (yield gpm) _____ (type power)
 - (7) electric log _____ (yes or no) _____ (organization running log)
 - (8) how well bottom plugged _____

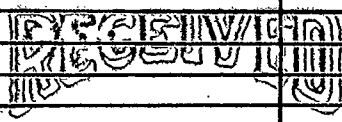


JAN 26 1990

Department of Natural Resources
 Bureau of Land & Water Resources

DRILLERS REMARKS: _____

If well telescopes please sketch and show depths.

GROUND LEVEL

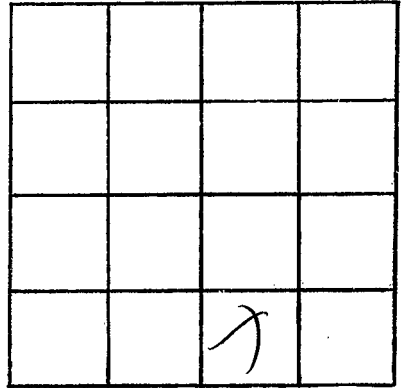

SECTION _____

Please indicate well location X.

ADDITIONAL INFORMATION

A series of horizontal lines for writing additional information, starting below the 'ADDITIONAL INFORMATION' header.

If more than one screen, show locations of each on sketch.