

MISSISSIPPI DEPARTMENT OF NATURAL RESOURCES

Bureau of Land and Water Resources

Southport Mall

P.O. Box 10631

Jackson, Mississippi 39209

WATER WELL DRILLERS LOG

C 2017

3/23

1992 Bud Denton

Jordan River

date well completed

firm name

county well located

LANDOWNER:	description of formations encountered	from	to
Kevin Dupree	Red shale	0	60
Wilsdale Rd	Red sand	60	170

(mailing address)

WELL LOCATION:

sec. 33 T 1 N R 15 E
 3 miles East of Wilsdale
 (distance) (direction) (nearest town)

WELL PURPOSE: home
 (home, irrigation, municipal, industrial)


WELL COMPLETION DATA:

- (1) diameter (inches) 4"
- (2) total depth (feet) 170
- (3) static water level (feet) 48 below top of ground.
- (4) casing pvc 170 (material) (depth)
- (size) If telescope see back.
- (5) screen 10 160 (length) (depth to top)
- 12 pvc (size) (material)
- (6) pump 1/2 12 (HP) (yield gpm)
- (type power)
- (7) electric log Elect (yes or no)

(organization running log)

(8) how well bottom plugged Sand
 Shale

DRILLERS REMARKS:

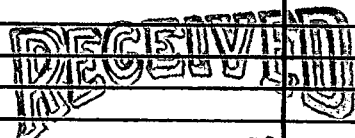


MAY 26 1992

Dept. of Environmental Quality
 Bureau of Land & Water Resources

If well telescopes please sketch and show depths.

GROUND LEVEL

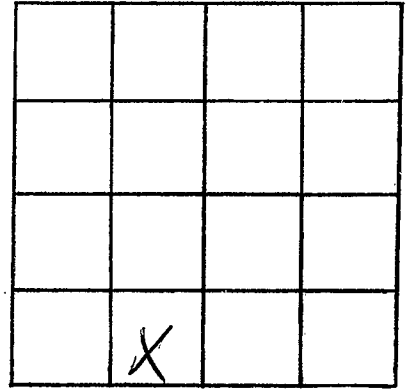

SECTION _____

Please indicate well location X.

ADDITIONAL INFORMATION

If more than one screen,
show locations of each on sketch.