

MISSISSIPPI DEPARTMENT OF ENVIRONMENTAL QUALITY
Bureau of Land and Water Resources

P. O. Box 10631
Jackson, MS 39289-0631
WATER WELL DRILLERS LOG

COUNTY WELL LOCATED
Pearl River
WELL NUMBER C CODED
2018
DATE WELL COMPLETED
11-29-93

PERMIT NUMBER
NAME OF DRILLING FIRM
Boones Water Well

NAME & MAILING ADDRESS OF LANDOWNER
Barry Aucion
I-84
Hillsdale
WELL LOCATION: SEC 24 TOWNSHIP 1 N RANGE 15 E
DISTANCE 5 Miles DIRECTION 5 of L70N NEAREST TOWN
OTHER LANDMARK
WELL PURPOSE Home, Irrigation, Municipal, Industrial, Fish Pond, etc.

PUMP DATA
PUMP TYPE (Circle One):
Submersible, Turbine, Jet Flowing Well,
Other (Describe) _____
POWER TYPE (Circle One):
Electric, Tractor, Diesel, Gasoline, Butane,
Other (Describe) _____ H/P 1
Pump Capacity (GPM) _____ No. of Stages _____ Setting Depth _____ FT.
PUMP TEST
Well yielded _____ GPM with
a drawdown of _____ ft.
after _____ hours of pumping

WELL DATA
Well Depth 45 Casing Diameter (In.) 2 Casing Length (Ft.) 35
Type of Casing sch 40 Hole Depth 45 Depth to Static Water Level _____
TYPE OF COMPLETION: (Circle One or More):
Gravel Packed, Underreamed, Telescoped,
Natural Development, Open Hole, Other
Top of Lap Pipe or Reduction in Casing _____ FEET
IF TELESCOPED OR MORE THAN ONE SCREEN: USE BACK PAGE

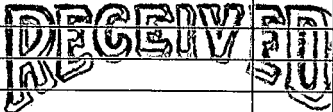
LOG DATA
TYPE OF LOG RUN (Circle One): No Log Run, Electric, Gamma Ray, Density, Sonic, Neutron, Other (Describe) _____
Name of Organization Running Log _____

SCREEN DATA
Diameter - Inches 2 Length - Feet 10 Slot Size - Inches 10
Screen Type sch 40 Depth to Bottom - Feet _____

GEOLOGIC DATA (Office Use Only)

Surface Elev.	Geologic Unit	Unit Thickness	Depth to Top
Subs. SWL	Date	Analysis	Aquifer Test

Driller's Remarks

DESCRIPTION OF FORMATIONS ENCOUNTERED	FROM TO		FORMATIONS (Continued)	FROM TO		
<u>Sand</u>	<u>0</u>	<u>45</u>	 <u>NOV 10 1993</u> Dept. of Environmental Quality Office of Land & Water Resources			

IF MORE SPACE IS NEEDED, USE BACK

If well telescopes please
sketch and show depths.

GROUND LEVEL

SECTION _____

Please indicate well location X.

ADDITIONAL INFORMATION

If more than one screen,
show location of each on sketch.