

**MISSISSIPPI DEPARTMENT OF ENVIRONMENTAL QUALITY**  
Office of Land and Water Resources

P. O. Box 10631  
Jackson, MS 39289-0631  
**WATER WELL DRILLERS LOG**

COUNTY WELL LOCATED <b>Pearl River</b>	
WELL NUMBER <b>C-2035</b>	CODED
DATE WELL COMPLETED <b>11-3-00</b>	

PERMIT NUMBER
NAME OF DRILLING FIRM <b>Boone's Water Well</b>

NAME & MAILING ADDRESS OF LANDOWNER <b>Mark Crawford</b>			
<b>22 Mason St</b>			
<b>Lumberton, MS 39455</b>			
WELL LOCATION:	SEC <b>19</b>	TOWNSHIP <b>1</b>	RANGE <b>N 15 E</b>
DISTANCE <b>5</b> Miles	DIRECTION <b>S</b>	NEAREST TOWN <b>Lumberton</b>	
OTHER LANDMARK			
WELL PURPOSE: <input checked="" type="checkbox"/> Home Irrigation, Municipal, Industrial, Fish Pond, etc.			

<b>PUMP DATA</b>		
PUMP TYPE (Circle One): <input checked="" type="checkbox"/> Submersible, <input type="checkbox"/> Turbine, <input type="checkbox"/> Jet, <input type="checkbox"/> Flowing Well, Other (Describe) _____		
POWER TYPE (Circle One): <input checked="" type="checkbox"/> Electric, <input type="checkbox"/> Tractor, <input type="checkbox"/> Diesel, <input type="checkbox"/> Gasoline, <input type="checkbox"/> Butane, Other (Describe) _____ H/P <b>1</b>		
Pump Capacity (GPM) <b>20</b>	No. of Stages	Setting Depth <b>FT.</b>
<b>PUMP TEST</b>		
Well yielded _____ GPM with a drawdown of _____ ft. after _____ hours of pumping		

<b>WELL DATA</b>		
Well Depth <b>160</b>	Casing Diameter (In.) <b>4</b>	Casing Length (Ft.) <b>140</b>
Type of Casing <b>Sch 40</b>	Hole Depth <b>160</b>	Depth to Static Water Level <b>80</b>
TYPE OF COMPLETION: (Circle One or More): <input checked="" type="checkbox"/> Gravel Packed, <input type="checkbox"/> Underreamed, <input type="checkbox"/> Telescoped, <input type="checkbox"/> Natural Development, <input type="checkbox"/> Open Hole, <input type="checkbox"/> Other (Describe) _____		

<b>LOG DATA</b>	
TYPE OF LOG RUN (Circle One): <input type="checkbox"/> No Log Run, <input type="checkbox"/> Electric, <input type="checkbox"/> Gamma Ray, <input type="checkbox"/> Density, <input type="checkbox"/> Sonic, <input type="checkbox"/> Neutron, Other (Describe) _____	
Name of Organization Running Log	

WELL GROUTED TO A DEPTH OF <b>10</b> FEET
Type Grout (circle one): <input checked="" type="checkbox"/> Cement, <input type="checkbox"/> Bentonite, or Mix

<b>GEOLOGIC DATA (Office Use Only)</b>			
Surface Elev.	Geologic Unit	Unit Thickness	Depth to Top
Subs. SWL	Date	Analysis	Aquifer Test
Driller's Remarks			
Top of Lap Pipe or Reduction in Casing			
<b>FEET</b>			
IF TELESCOPED OR MORE THAN ONE SCREEN: USE BACK PAGE			

<b>SCREEN DATA</b>		
Diameter - Inches <b>4</b>	Length - Feet <b>20</b>	Slot Size - Inches <b>#8</b>
Screen Type <b>Sch 40</b>	Depth to Bottom - Feet	


DESCRIPTION OF FORMATIONS ENCOUNTERED	FROM	TO
<b>Sand</b>	<b>0</b>	<b>65</b>
<b>Clay</b>	<b>65</b>	<b>120</b>
<b>Sand</b>	<b>120</b>	<b>160</b>

FORMATIONS (Continued)	FROM	TO

**REC'D AUG 24 2001**

If well telescopes please  
sketch and show depths.

GROUND LEVEL

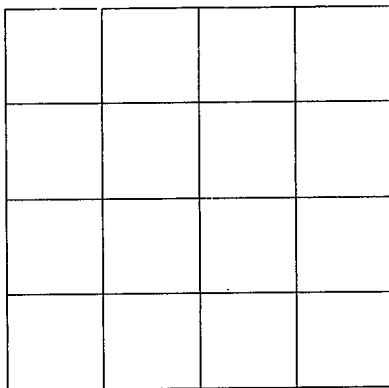

SECTION \_\_\_\_\_

Please indicate well location X.

ADDITIONAL INFORMATION

If more than one screen,  
show location of each on sketch.