

**MISSISSIPPI DEPARTMENT OF ENVIRONMENTAL QUALITY**

Office of Land and Water Resources

P. O. Box 10631  
Jackson, MS 39289-0631  
**WATER WELL DRILLERS LOG**

COUNTY WELL LOCATED:  
Pearl River

WELL NUMBER: C-2036 CODED: \_\_\_\_\_

DATE WELL COMPLETED:  
3-15-01

PERMIT NUMBER: \_\_\_\_\_

NAME OF DRILLING FIRM:  
Binne's Waterwell

NAME & MAILING ADDRESS OF LANDOWNER:  
Charles Sidock  
151 John Smith Rd  
Poplarville, MS 39470

WELL LOCATION: SEC 30 TOWNSHIP 1 RANGE 15 N E MS

DISTANCE 6 Miles DIRECTION NW of NEAREST TOWN Poplarville

OTHER LANDMARK: \_\_\_\_\_

WELL PURPOSE:  Home Irrigation,  Municipal,  Industrial,  Fish Pond, etc.

**PUMP DATA**

PUMP TYPE (Circle One):  
 Submersible,  Turbine,  Jet,  Flowing Well,  
Other (Describe) \_\_\_\_\_

POWER TYPE (Circle One):  
 Electric,  Tractor,  Diesel,  Gasoline,  Butane,  
Other (Describe) \_\_\_\_\_ H/P \_\_\_\_\_

Pump Capacity (GPM) 20 No. of Stages \_\_\_\_\_ Setting Depth \_\_\_\_\_ FT.

PUMP TEST

Well yielded \_\_\_\_\_ GPM with  
a drawdown of \_\_\_\_\_ ft.  
after \_\_\_\_\_ hours of pumping

**WELL DATA**

Well Depth <u>75</u>	Casing Diameter (In.) <u>4</u>	Casing Length (Ft.) <u>65</u>
Type of Casing <u>Sch 40</u>	Hole Depth <u>75</u>	Depth to Static Water Level <u>30</u>

**LOG DATA**

TYPE OF LOG RUN (Circle One):  
 No Log Run,  Electric,  Gamma Ray,  Density,  Sonic,  Neutron,  
Other (Describe) \_\_\_\_\_

Name of Organization Running Log: \_\_\_\_\_

TYPE OF COMPLETION: (Circle One or More):  
 Gravel Packed,  Underreamed,  Telescoped,  
 Natural Development,  Open Hole,  Other  
(Describe) \_\_\_\_\_

WELL GROUTED TO A DEPTH OF 10 FEET  
Type Grout (circle one):  Cement,  Bentonite, or Mix

**GEOLOGIC DATA (Office Use Only)**

Surface Elev.	Geologic Unit	Unit Thickness	Depth to Top
Subs. SWL	Date	Analysis	Aquifer Test

Driller's Remarks: \_\_\_\_\_

Top of Lap Pipe or Reduction in Casing \_\_\_\_\_

**FEET** IF TELESCOPED OR MORE THAN ONE SCREEN: USE BACK PAGE

**SCREEN DATA**


Diameter - Inches <u>4</u>	Length - Feet <u>20</u>	Slot Size - Inches <u>#8</u>
Screen Type <u>Sch 40</u>	Depth to Bottom - Feet	

DESCRIPTION OF FORMATIONS ENCOUNTERED	FROM		TO		FORMATIONS (Continued)	FROM		TO	
<u>Clay</u>	<u>0</u>	<u>8</u>							
<u>Sand</u>	<u>8</u>	<u>15</u>							

**RECD AUG 24 2001**

If well telescopes please  
sketch and show depths.

GROUND LEVEL

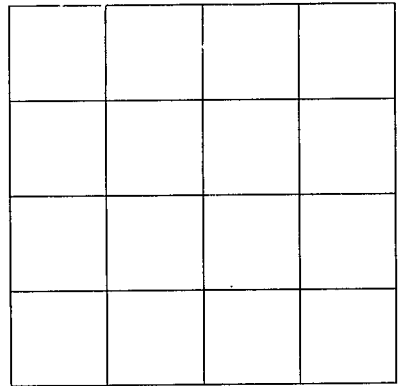

SECTION \_\_\_\_\_

Please indicate well location X.

ADDITIONAL INFORMATION

A series of horizontal lines for providing additional information, starting below the 'ADDITIONAL INFORMATION' header and extending to the bottom of the page.

If more than one screen,  
show location of each on sketch.