

Pearl R.

D-4

8-9-60

WATER WELL DRILLERS LOG

C-301

Date: Aug 9, 1960, Driller: Leo Lashley (Name) CODED (Location)

(1) Owner of Land: Mrs Ann. Lashley (Name) Lumberton Miss R1 (Address)

Description & Color of Materials Sand, Clay, Red Clay, Shell, etc.	Thick- ness Feet	Depth Feet
Red Clay	40	0-40
Sand	60	40-100

(2) Location: 1/4, 1/4, Sec. 3-T1 R14, 3 1/2 miles East of Lumberton (distance) (direction) (Nearest Town)

(3) Topography: (Hilly) (Flat) (Level)

(4) Purpose of Well: (Domestic Irrigation) (Municipal, Industrial, Other)

Information upon completion of well:

(1) Diameter 4 inches.

(2) Total Depth 100 feet.

(3) Water Level 50 feet below top of ground.

(4) Cased to 100, Size 4

(5) Screen: Size 4", Length 6'


(6) Were any formations sealed against pollution? yes, no.

If YES depth of formation

Why

Drillers Remarks:

CODED

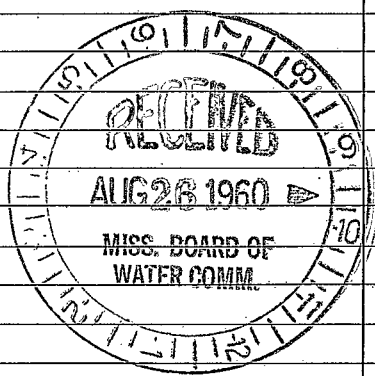

(Use Back Side)

Well No.

