

Pearl R.  
D-5  
11-11-60

WATER WELL DRILLERS LOG

C-300

Date: Nov 11, 1960, Driller: Leo Laha County: Phillips  
(Name)

**CODED**

(1) Owner of Land: John Willenbrock  
(Name)

Description & Color of  
Sand, Clay, Red Clay, etc.

Thick-  
ness  
Feet

Depth  
Feet

Leontine Miss  
(Address)

Sandy clay  
Clay  
Sand

48 or 48  
42 48-90  
34 70-74

(2) Location: 1/4, 1/4, Sec. 12 T. 1 R. 19

7 miles East of Leontine  
(distance) (direction) (Nearest Town)

(3) Topography: Hilly (Hilly) (Flat) (Level)

(4) Purpose of Well: Home Use  
(Domestic Irrigation  
Municipal, Industrial, Other)

Information upon completion of well:

(1) Diameter: 2 inches.

(2) Total Depth: 124 feet.


(3) Water Level: 30 feet below top of ground.

(4) Cased to: 119, Size: 2"

(5) Screen: Size 2x60, Length 5ft

(6) Were any formations sealed against pollution?  
no

**CODED**

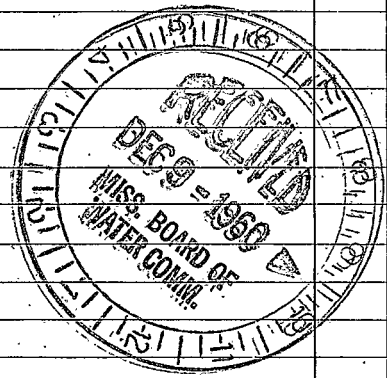

If YES depth of formation \_\_\_\_\_

Why \_\_\_\_\_

Drillers Remarks: \_\_\_\_\_

(Use Back Side)

[Signature]

Well No.

11/11/11

11/11/11

11/11/11