

D-6  
5-61

WATER WELL DRILLERS LOG

C-307

Date: May, 1961, Driller: Leo Lader

**CODED**  
County: ALVERN

(1) Owner of Land: Alvern Wash  
(Name)  
Rt 1 Lumberton  
(Address)

Description & Color of Materials Sand, Clay, Red Clay, Shell, etc.	Thick- ness Feet	Depth Feet
<u>glandy clay</u>	<u>15-18</u>	
<u>sand</u>	<u>45</u>	<u>15-60</u>

(2) Location: 1/4, 1/4, Sec. 33 T14N R14,  
3 miles East, of Lumberton  
(distance) (direction) (Nearest Town)

(3) Topography:  (Hilly)  (Flat)  (Level)

(4) Purpose of Well: Home use  
(Domestic Irrigation  
Municipal, Industrial, Other)

Information upon completion of well:

(1) Diameter 4 inches.

(2) Total Depth 60 feet.

(3) Water Level 30 feet below top of ground.

(4) Cased to 60, Size 4"

(5) Screen: Size 0.42, Length 5'


(6) Were any formations sealed against pollution?  
no

If YES depth of formation \_\_\_\_\_

Why \_\_\_\_\_

Drillers Remarks: \_\_\_\_\_

**CODED**

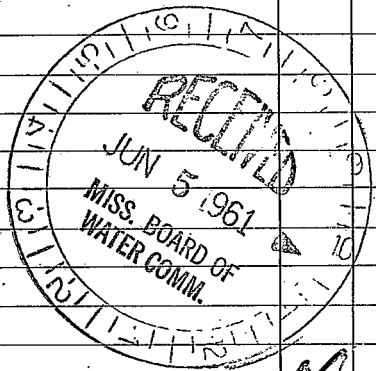

40

Well No.

(Use Back Side)

16