

PEARL RIVER
D9
12-23-71

MISSISSIPPI
BOARD OF WATER COMMISSIONERS
416 North State Street
Jackson, Mississippi 39201

CODED

WATER WELL DRILLERS LOG

12-23 1971 Parwell Anderson Pearl River
date well completed firm name county well located

LANDOWNER: Mervin Ledet

Lumberton MS
(mailing address)

WELL LOCATION:
sec. 26 T. 1 N. R. 14E
S W
10 miles E of Lumberton
(distance) (direction) (nearest town)

WELL PURPOSE: Home
(home, irrigation, municipal, industrial)

- WELL COMPLETION DATA:
- (1) diameter (inches) 2
 - (2) total depth (feet) 57
 - (3) static water level (feet) 35' below above top of ground.
 - (4) casing Plastic 52'
(material) (depth)
 - _____ If telescope see back.
(size)
 - (5) screen 5 52'
(length) (depth to top)
 - 2" Plastic
(size) (material)
 - (6) pump 1 10
(HP) (yield gpm)
 - Elect
(type power)
 - (7) electric log _____
(yes or no)
 - _____ (organization running log)
 - (8) how well bottom plugged
Backwash Valve

description of formations encountered	from	to
Top Soil	0	3
Red Sandy Clay	3	26
Red Sand	26	38
Red Clay	38	49
Coarse Sand	49	57

CODED


DRILLERS REMARKS:

DEC 8 1971

MISS. Bd. of
WATER COMM.

If well telescopes please
sketch and show depths.

GROUND LEVEL

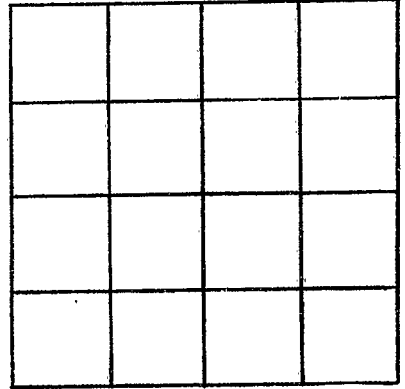

SECTION _____

Please indicate well location X.

ADDITIONAL INFORMATION

If more than one screen,
show locations of each on sketch.