

CODED

MISSISSIPPI  
BOARD OF WATER COMMISSIONERS  
416 North State Street  
Jackson, Mississippi 39201

CODED

WATER WELL DRILLERS LOG

Pearl River  
D 10  
4-17-68

4-17 1968  
date well completed

L. W. Smith  
firm name

Pearl River  
county well located

LANDOWNER:  
Cleve Walters  
Sumberton  
(mailing address)

description of formations encountered	from	to
Tephrit	0	3
Clay	3	20
Sand	20	50
Sand & Gravel	50	70
Clay		

WELL LOCATION:  
sec. 1 T 1 S R 14 W  
4 miles W of Sumberton  
(distance) (direction) (nearest town)

WELL PURPOSE:  
(home, irrigation, municipal, industrial)

WELL COMPLETION DATA:

(1) diameter (inches) 2

(2) total depth (feet) 70

(3) static water level (feet) 25 below top of ground.

(4) casing Plastic 70  
(material) (depth)

\_\_\_\_\_ If telescope see back.  
(size)

(5) screen 5 65  
(length) (depth to top)

\_\_\_\_\_ (size) \_\_\_\_\_ (material)

(6) pump 1 14  
(HP) (yield gpm)

Electric  
(type power)

(7) electric log \_\_\_\_\_  
(yes or no)

\_\_\_\_\_ (organization running log)

(8) how well bottom plugged Backed

CODED


FEB 4 1968

MISS. BD. OF  
WATER COMM.

DRILLERS REMARKS:

If well telescopes please sketch and show depths.

GROUND LEVEL

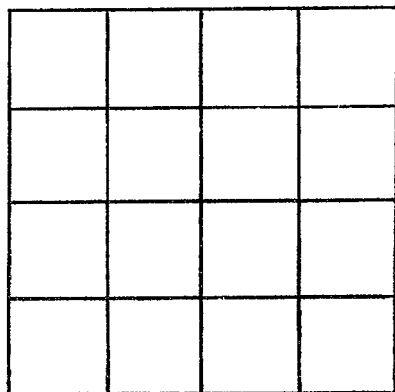

SECTION 1

Please indicate well location X.

ADDITIONAL INFORMATION

If more than one screen, show locations of each on sketch.