

32 1 N 14 W

Lumberton

CODED

Pearl River

MISSISSIPPI
BOARD OF WATER COMMISSIONERS
416 North State Street
Jackson, Mississippi 39201

D 11
9-68

WATER WELL DRILLERS LOG

CODED

date well completed

firm name

county well located

LANDOWNER:

description of formations encountered

from to

WELL LOCATION:


sec 32 T14N R14E
2 miles E of Lumberton
(distance) (direction) (nearest town)

WELL PURPOSE:
(home, irrigation, municipal, industrial)

WELL COMPLETION DATA:


- (1) diameter (inches) 2
- (2) total depth (feet) 44
- (3) static water level (feet) 20 below top of ground.
- (4) casing 4" (material) 40' (depth)
2" if telescope see back.
(size)
- (5) screen 5' (length) 39' (depth to top)
1/2" (size) PVC (material)
- (6) pump 1 (HP) 10 (yield gpm)
(type power)
- (7) electric log (yes or no)
- (organization running log)
- (8) how well bottom plugged Blk Nitro

DRILLERS REMARKS:

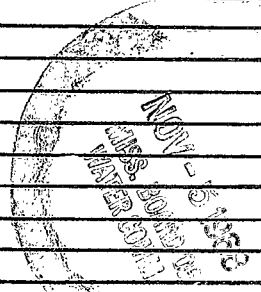

If well telescopes please sketch and show depths.

GROUND LEVEL

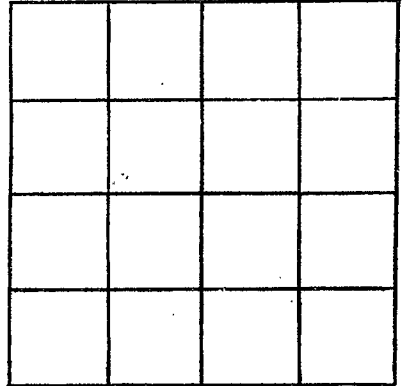

SECTION _____

Please indicate well location X.

ADDITIONAL INFORMATION

If more than one screen, show locations of each on sketch.