

Pearl River
 D 12
 4-3-69

MISSISSIPPI
 BOARD OF WATER COMMISSIONERS
 416 North State Street
 Jackson, Mississippi 39201

CODED

WATER WELL DRILLERS LOG

4-3 1969 Ed Lubet Pearl River
 date well completed firm name county well located

LANDOWNER:	Description of formations encountered	from	to
		ft	ft
<u>Ed Lubet</u>	<u>Surface</u>	<u>0</u>	<u>1</u>
<u>Pt 1 Lumberton</u> (mailing address)	<u>Clay</u>	<u>1</u>	<u>14</u>
	<u>Sand</u>	<u>14</u>	<u>30</u>

WELL LOCATION:
 sec 32 T 1 N R E
2 miles S of W
 (distance) (direction) (nearest town)

WELL PURPOSE: HOMER
 (home, irrigation, municipal, industrial)

- WELL COMPLETION DATA:
- diameter (inches) 3"
 - total depth (feet) 38
 - static water level (feet) 14 below above top of ground.
 - casing PVC 33
(material) (depth)
2" if telescope see back.
(size)
 - screen 5' 33
(length) (depth to top)
0.12 PVC
(size) (material)
 - pump 1/2 10
(HP) (yield gpm)

(type power)
 - electric log NO
(yes or no)

(organization running log)
 (8) how well bottom plugged BW Value


DRILLERS REMARKS:

APR 17 1969

MISS. BD. OF
 WATER COM.

If well telescopes please sketch and show depths.

GROUND LEVEL

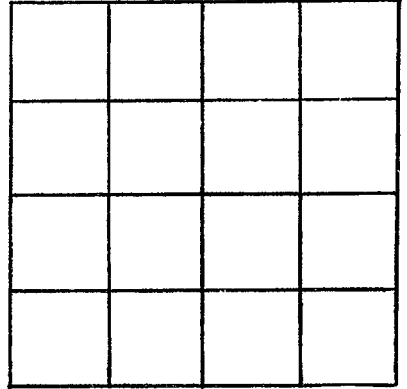

SECTION 32

Please indicate well location X.

ADDITIONAL INFORMATION

If more than one screen, show locations of each on sketch.