

Pearl River
D13
5-21-69

MISSISSIPPI
 BOARD OF WATER COMMISSIONERS
 416 North State Street
 Jackson, Mississippi 39201

CODED

WATER WELL DRILLERS LOG

date well completed 5-21 19 69 firm name New L. Lee Pearl River county well located _____

LANDOWNER: Standard Oil Co
RF-1
Kumbles, Mrs
 (mailing address)

description of formations encountered	from	to
	<u>T. Sand</u>	<u>0</u>
<u>Clay</u>	<u>2</u>	<u>7</u>
<u>Sand</u>	<u>7</u>	<u>7</u>

WELL LOCATION:
 sec 2 T 1 N 14 R W
24 miles E of Shannon
 (distance) (direction) (nearest town)

WELL PURPOSE: Domestic
 (home, irrigation, municipal, industrial)

- WELL COMPLETION DATA:
- (1) diameter (inches) 4"
 - (2) total depth (feet) 70
 - (3) static water level (feet) 33 below top of ground.
 - (4) casing PVC 44'
 (material) (depth)
4" If telescope see back.
 (size)
 - (5) screen 6' 64'
 (length) (depth to top)
012 PVC
 (size) (material)
 - (6) pump 3/4 25
 (HP) (yield gpm)
Electric
 (type power)
 - (7) electric log NO
 (yes or no)
 (organization running log)
 - (8) how well bottom plugged BNV


JUN 9 - 1969

MISS. BD. OF
 WATER COMMISSIONERS

DRILLERS REMARKS:

If well telescopes please sketch and show depths.

GROUND LEVEL

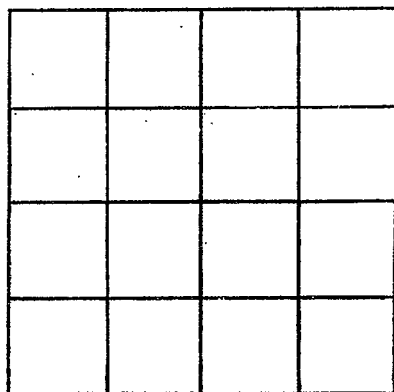

SECTION 5

Please indicate well location X.

ADDITIONAL INFORMATION

If more than one screen, show locations of each on sketch.