

CODED

MISSISSIPPI
BOARD OF WATER COMMISSIONERS
416 North State Street
Jackson, Mississippi 39201

WATER WELL DRILLERS LOG

Pearl River
D 14
12-26-69

Dec. 26 1969
date well completed

John Smith Well Service
firm name

Pearl River
county well located

LANDOWNER: Julius Ferguson
Lumberton miss

(mailing address)

| description of formations encountered | from | to |
|---------------------------------------|--|----------|
| | <u>1/2 clay</u> <u>2' sand & gravel</u> | <u>1</u> |

WELL LOCATION:
sec. 2 T 1 N R 14 E
6 miles East of Lumberton
(distance) (direction) (nearest town)

WELL PURPOSE:
(home, irrigation, municipal, industrial)

- WELL COMPLETION DATA:
- (1) diameter (inches) 2 in
 - (2) total depth (feet) 34
 - (3) static water level (feet) 14 below above top of ground.
 - (4) casing plastic 34
(material) (depth)
(size) if telescope see back.
 - (5) screen 5 ft 29
(length) (depth to top)
2 in plastic
(size) (material)
 - (6) pump 1/2 4
(HP) (yield gpm)
etc.
(type power)
 - (7) electric log (yes or no) (no)

(organization running log)
 - (8) how well bottom plugged _____


JAN - 7 1970

MISS. BD. OF
WATER COMM.

DRILLERS REMARKS:

If well telescopes please sketch and show depths.

GROUND LEVEL

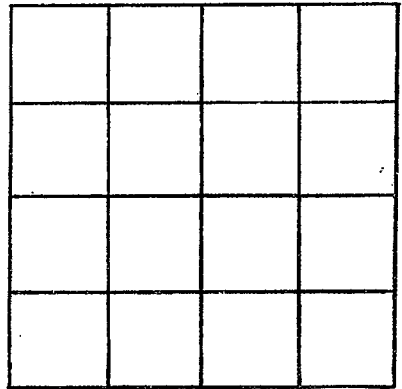

SECTION 2

Please indicate well location X.

ADDITIONAL INFORMATION

If more than one screen, show locations of each on sketch.