

CODED

Pearl River  
 D16  
 11-30-69  
 11-30

MISSISSIPPI  
 BOARD OF WATER COMMISSIONERS  
 416 North State Street  
 Jackson, Mississippi 39201

*[Handwritten signature]*

WATER WELL DRILLERS LOG

*[Handwritten signature]*

date well completed

firm name

county well located

LANDOWNER: *James M. Hugg*

description of formations encountered

from to

*Rt 2*  
*Lumberton, Miss*  
 (mailing address)

*Surface*  
*Clay*  
*Sand*  
*Clay*  
*Sand*

0	1
17	12
17	38
38	130
130	218

WELL LOCATION:

sec 34 T N R 14 E  
 1 S 14 W  
5 miles S of Lumberton  
 (distance) (direction) (nearest town)

WELL PURPOSE: *Comp*  
 (home, irrigation, municipal, industrial)

WELL COMPLETION DATA:

- (1) diameter (inches) 2"
- (2) total depth (feet) 218
- (3) static water level (feet) 87 below above top of ground,
- (4) casing PTC 2 1/2" (material) (depth)  
2 (size) if telescope see back.
- (5) screen 5' 2 1/2" (length) (depth to top)  
2" (size) PTC (material)
- (6) pump 1 (HP) 10 (yield gpm)  
Elec (type power)
- (7) electric log No (yes or no)

(organization running log)

(8) how well bottom plugged BW


DRILLERS REMARKS:

JAN - 5 1970

MISS. BD. OF WATER COM.

If well telescopes please sketch and show depths.

GROUND LEVEL

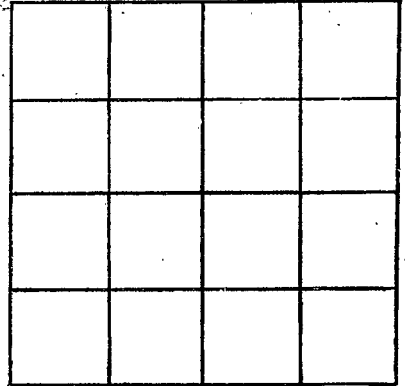

SECTION 36

Please indicate well location X.

ADDITIONAL INFORMATION

If more than one screen, show locations of each on sketch.