

CODED

Pearl River
D 17
12-29-69

MISSISSIPPI
BOARD OF WATER COMMISSIONERS
416 North State Street
Jackson, Mississippi 39201

WATER WELL DRILLERS LOG

Dec 29 1969 date well completed
John Carter Well Service firm name
Pearl River county well located

LANDOWNER: <u>Julius Ferguson</u> <u>Lumberton Miss</u> (mailing address)	description of formations encountered <u>Clay</u> <u>Sh + gravel</u>	from <u>1</u>	to <u>15</u> <u>34</u>				
WELL LOCATION:							
sec. <u>2</u> T. <u>1</u> N. R. <u>14</u> E							
<table border="0" style="width:100%"> <tr> <td style="text-align:center">S</td> <td style="text-align:center">W</td> </tr> <tr> <td style="text-align:center">6</td> <td style="text-align:center">East</td> </tr> </table> miles (distance) (direction) of <u>Lumberton</u> (nearest town)				S	W	6	East
S	W						
6	East						
WELL PURPOSE: (home, irrigation, municipal, industrial)							
WELL COMPLETION DATA:							
(1) diameter (inches) <u>2 in</u>							
(2) total depth (feet) <u>34</u>							
(3) static water level (feet) <u>14</u> below above top of ground.							
(4) casing <u>plastic</u> <u>34</u> (material) (depth)							
_____ (size) if telescope see back.							
(5) screen <u>10 FT</u> <u>21 FT</u> (length) (depth to top)							
<u>3 in</u> <u>plastic</u> (size) (material)							
(6) pump <u>3</u> <u>8</u> (HP) (yield gpm)							
<u>elec</u> (type power)							
(7) electric log <u>(yes or no)</u>							
_____ (organization running log)							
(8) how well bottom plugged _____							


JAN - 7 1970

MISS. Bd. Of
WATER COMM.

DRILLERS REMARKS:

If well telescopes please sketch and show depths.

GROUND LEVEL

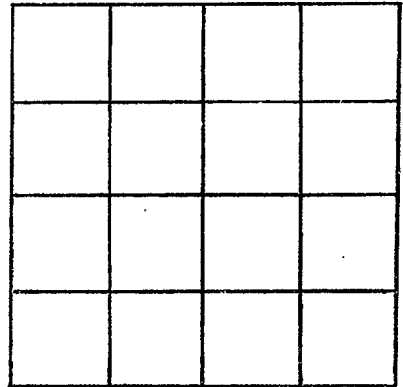

SECTION 2

Please indicate well location X.

ADDITIONAL INFORMATION

If more than one screen, show locations of each on sketch.