

P. R.
D22
5175

MISSISSIPPI
BOARD OF WATER COMMISSIONERS
416 North State Street
Jackson, Mississippi 39201

CODED

WATER WELL DRILLERS LOG ⁰³⁸

April/MAY date well completed 75 KRINER DRILLING SERVICE firm name PEARL RIVER county well located

LANDOWNER: SAGA PETROLEUM
U.S.A., 2120 14th St
Gulfport, Miss. 39501
Delta Rig #66 - CONTROL BOX (mailing address)

description of formations encountered	from to	
SAND + CLAY	0	115
CLAY	115	178
SAND	178	198
W. CLAY	198	357
SAND	357	441
CLAY	441	462

WELL LOCATION: 1792' S + 2146' W
of NE COR.
sec. 15 T 1 N R 14 E
(S) (W)

_____ miles of _____
(distance) (direction) (nearest town)

WELL PURPOSE: oil well supply
(home, irrigation, municipal, industrial)

WELL COMPLETION DATA:

- (1) diameter (inches) 6"
- (2) total depth (feet) 441
- (3) static water level (feet) 115' ^{below} top of ground.
- (4) casing B.I.
(material) (depth)
6" If telescope see back.
(size)
- (5) screen 20' 421'
(length) (depth to top)
6" 304 S.S.
(size) (material)
- (6) pump 10 150 PUMP
(HP) (yield gpm) set @ 27 ft.
- Elect. Generator on Rig
(type power)
- (7) electric log NO
(yes or no)

(organization running log)

(8) how well bottom plugged BACK
WASH VALVE


DISCOVERED
MAY 12 1975

DRILLERS REMARKS:

MISS. BD. OF WATER COMMISSIONERS

If well telescopes please sketch and show depths.

GROUND LEVEL

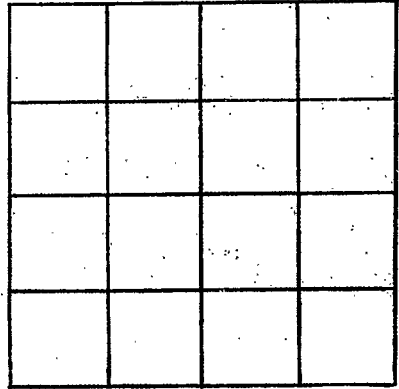

SECTION _____

Please indicate well location X.

ADDITIONAL INFORMATION

If more than one screen, show locations of each on sketch.