

PEARL RIVER

D-23

7/12/80

MISSISSIPPI BOARD OF WATER COMMISSIONERS
416 North State Street
Jackson, Mississippi 39201

CODED

WATER WELL DRILLERS LOG

date well completed

firm name

county well located

7-1280 Gruner Drilling Pearl River

LANDOWNER:
Tomlinson Interest
2201 Hardy Street
Hattiesburg, Ms.
(mailing address)

description of formations encountered	from	to
clay + fill	0	105
clay	105	171
sand	171	191
clay	191	275
clay + sand	275	290
sand	290	358
clay	358	378

WELL LOCATION: 3341'S + 2578'W
no 1 sec 2 T 1 N R 14 E of NE100
Sawyer Young, Ms.
(distance) miles (direction) of (nearest town)

WELL PURPOSE: oil field
(home, irrigation, municipal, industrial)

WELL COMPLETION DATA:
(1) diameter (inches) 4"
(2) total depth (feet) 378'
(3) static water level (feet) 90' (below above top of ground)
(4) casing steel, 358'
(material) (depth)
4" (size) if telescope see back.
(5) screen 42', 316'
(length) (depth to top)
4" (size) perforated (material)
(6) pump 20
(HP) (yield gpm)
AC (type power)
(7) electric log (yes or no)

(organization running log)
(8) how well bottom plugged
open se
plug

DRILLERS REMARKS:


DEPT. OF NATURAL RESOURCES
BUREAU OF LAND & WATER RESOURCES

JUL 28 1980

RECEIVED

If well telescopes please
sketch and show depths.

GROUND LEVEL

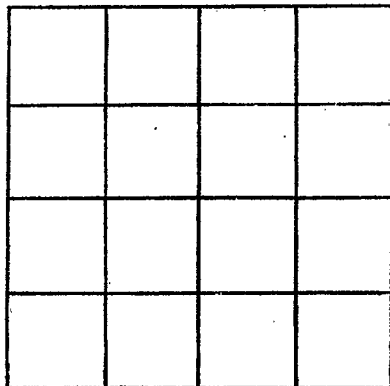

SECTION _____

Please indicate well location X.

ADDITIONAL INFORMATION

If more than one screen,
show locations of each on sketch.