

MISSISSIPPI DEPARTMENT OF NATURAL RESOURCES

Bureau of Land and Water Resources

Southport Mall

P.O. Box 10631

Jackson, Mississippi 39209

WATER WELL DRILLERS LOG

Griner Drilling Service, Inc.

Pearl River

CODED

Pearl River  
D25  
9-23-81

date well completed

firm name

county well located

LANDOWNER:	description of formations encountered	from	to
Dar-Co Drilling Co. P.O. Box 873 Natchez, MS 39120 (mailing address)			
WELL LOCATION: 1650' N + 1850' E sec. 17 T. 1 N R. 14 E SW/4 cor No. 1 Lumberton Area 1/2 mile S of (nearest town) (distance) (direction) (nearest town) (home, irrigation, municipal, industrial) supply	streaked chalk	84	294
WELL COMPLETION DATA: (1) diameter (inches) 3" (2) total depth (feet) 504' (3) static water level (feet) 50' below top of ground. (4) casing steel 483' (material) (depth) 3" (size) if telescope see back. (5) screen 42' (length) 441' (depth to top) 3" perforated (size) (material) (6) pump — 75 (HP) (yield gpm) AC (type power) (7) electric log — (yes or no) (organization running log) (8) how well bottom plugged orange peel	chalk	294	430
	sand, pea gravel	430	483
	chalk	483	504
DRILLERS REMARKS:			

CODED


DEPT. OF NATURAL RESOURCES  
BUREAU OF LAND & WATER RESOURCES

OCT - 6 1981

RECEIVED

If well telescopes please sketch and show depths.

GROUND LEVEL

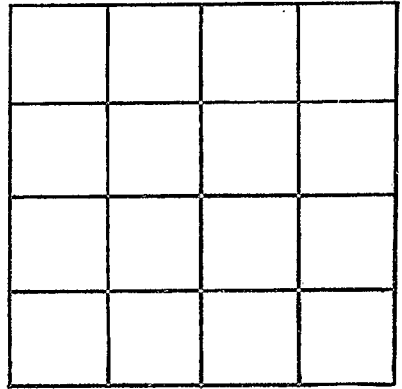

SECTION \_\_\_\_\_

Please indicate well location X.

ADDITIONAL INFORMATION

If more than one screen,  
show locations of each on sketch.