

MISSISSIPPI DEPARTMENT OF NATURAL RESOURCES

Bureau of Land and Water Resources

Southport Mall

P.O. Box 10631

Jackson, Mississippi 39209

WATER WELL DRILLERS LOG

BUD PENTON & SONS

Water Well Service

(firm name)

county well located

CODED

Pearl River

PEARL RIVER
D50
7-20-85

7/90 1985
date well completed

1985

LANDOWNER: *Stephen Lano*
RT. 7 Box 125 Bay
Saint Louis
(mailing address)

description of formations encountered

from to

<i>Red Shale</i>	<i>0</i>	<i>70</i>
<i>Red Sand</i>	<i>70</i>	<i>90</i>
<i>Blue Shale</i>	<i>90</i>	<i>200</i>
<i>Gray Sand</i>	<i>200</i>	<i>241</i>

WELL LOCATION:

sec. *25* T. *1* N. R. *14* E.
2 miles *E* of *Sill Dale*
(distance) (direction) (nearest town)

WELL PURPOSE: *home*
(home, irrigation, municipal, industrial)

WELL COMPLETION DATA:

- (1) diameter (inches) *4*
- (2) total depth (feet) *241*
- (3) static water level (feet) *100* below top of ground.
- (4) casing *PVC*, *241*,
(material) (depth)
70 if telescope see back.
(size)
- (5) screen *10*, *231*,
(length) (depth to top)
12, *pvc*
(size) (material)
- (6) pump *1*, *1350*,
(HP) (yield gpm)
Elut
(type power)
- (7) electric log *no*
(yes or no)

(organization running log)

(8) how well bottom plugged *Spud*

DRILLERS REMARKS:


RECEIVED

NOV 19 1985

Department of Natural Resources
Bureau of Land & Water Resources

If well telescopes please sketch and show depths.

GROUND LEVEL

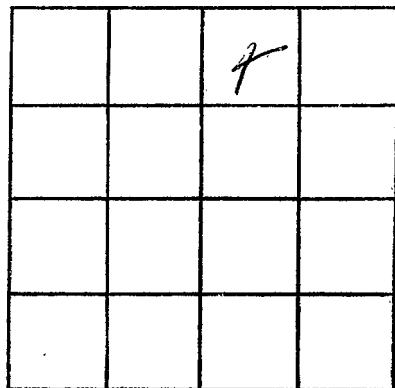

SECTION _____

Please indicate well location X.

ADDITIONAL INFORMATION

If more than one screen,
show locations of each on sketch.