

MISSISSIPPI DEPARTMENT OF NATURAL RESOURCES

Bureau of Land and Water Resources

Southport Mall

P.O. Box 10631

Jackson, Mississippi 39209

WATER WELL DRILLERS LOG

Griner Drilling Service, Inc.

Pearl River

Pearl River
D 56

9-6-87
date well completed

firm name

county well located

LANDOWNER:	description of formations encountered	from	to
<i>Delta Drilling</i> <i>P.O. Box 52787 OCS</i> <i>Lafayette, La. 70505</i> (mailing address)	<i>clay, sand, rock</i>	<i>0</i>	<i>287</i>
WELL LOCATION: <i>500' N & 2050' W</i> sec. <i>14</i> T <i>1</i> N R <i>14</i> E of <i>No. 11 Distal Ridge</i> <i>well</i> (distance) miles (nearest town) <i>14</i> <i>SE/CO</i> WELL PURPOSE: <i>Ditfield rig</i> (home, irrigation, municipal, industrial) <i>supply</i>	<i>sand, little gravel</i>	<i>287</i>	<i>347</i>
WELL COMPLETION DATA: (1) diameter (inches) <i>3"</i> (2) total depth (feet) <i>347'</i> (3) static water level (feet) <i>90'</i> <input checked="" type="radio"/> below <input type="radio"/> above top of ground. (4) casing <i>steel, 336'</i> (material) (depth) <i>3"</i> (size) If telescope see back. (5) screen <i>42', 294'</i> (length) (depth to top) <i>3" perforated</i> (size) (material) (6) pump <i>—</i> <i>75</i> (HP) (yield gpm) <i>AC</i> (type power) (7) electric log <i>(yes or no)</i> <i>(organization running log)</i> (8) how well bottom plugged <i>orange peel</i>	<i>500' N and 2050' W of</i> <i>SE corner</i>		
DRILLERS REMARKS:			


RECEIVED
INDEX

OCT 19 1987

Department of Natural Resources
Bureau of Land & Water Resources

If well telescopes please
sketch and show depths.

GROUND LEVEL

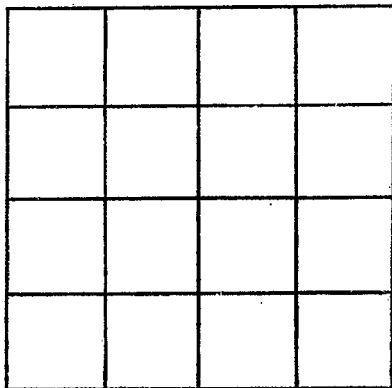

SECTION _____

Please indicate well location X.

ADDITIONAL INFORMATION

If more than one screen,
show locations of each on sketch.