

MISSISSIPPI DEPARTMENT OF NATURAL RESOURCES

Bureau of Land and Water Resources

Southport Mall

P.O. Box 10631

Jackson, Mississippi 39209

WATER WELL DRILLERS LOG

P. River CODED
D 51
7/2/88

Griner Drilling Service, INC.

Pearl River

7-2-88 date well completed

Griner Drilling Service, INC. firm name

Pearl River county well located

LANDOWNER:

Tesoro Petroleum Corp.
P.O. Box 2909
Laurel, Ms. 39440
 (mailing address)

description of formations encountered

from

to

Sand, pea gravel 0 65

Clay, sand, 65 399

W mostly clay

SAND 399 483

WELL LOCATION:

1146' N & 1500' W of
 spc. 13 T 1 N R 14 E of
 No. 1 USA W. Pistol Ridge Field
 (distance) (direction) (nearest town)

WELL PURPOSE: oilfield rig supply
 (home, irrigation, municipal, industrial)

WELL COMPLETION DATA:

- (1) diameter (inches) 3"
- (2) total depth (feet) 483'
- (3) static water level (feet) 70' ^{below} _{above} top of ground.

- (4) casing steel, 483'
 (material) (depth)
3"
 (size) if telescope see back.


- (5) screen 42', 441'
 (length) (depth to top)
3" perforated
 (size) (material)

- (6) pump — 80-85
 (HP) (yield gpm)
AC
 (type power)

- (7) electric log —
 (yes or no)
 (organization running log)

- (8) how well bottom plugged orange
peel


DRILLERS REMARKS:

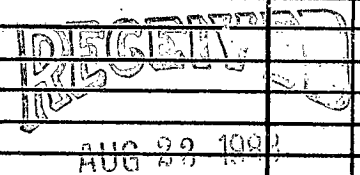

Department of Natural Resources
 Bureau of Land & Water Resources

If well telescopes please sketch and show depths.

GROUND LEVEL

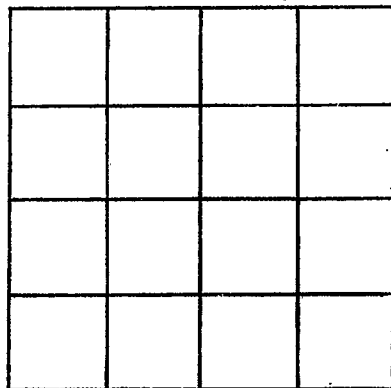

SECTION _____

Please indicate well location X.

ADDITIONAL INFORMATION

If more than one screen, show locations of each on sketch.