

# State Well Report

## Part 1

Mississippi Department of Environmental Quality  
Office of Land and Water Resources  
P.O. Box 10631  
Jackson, MS 39289-0631  
(601)961-5210  
(601)354-6938 (fax)

County: Pearl River  
Permit #: \_\_\_\_\_  
Driller: Michael S. Harold  
Date drilling completed: 11-28-05

For Office Use Only:  
Aquifer: \_\_\_\_\_  
Well #: D-92  
L. S. Elevation: \_\_\_\_\_  
E-log #: \_\_\_\_\_

State Law requires that this report be prepared by the driller in detail and filed with the Department within 30 days of completion of drilling of the well.

Well Owner Information	Well Location
Owner Name <u>Meru. Kritzman</u>	Latitude: <u>30° 56' 024"</u> Longitude <u>89° 23' 454"</u>
Mailing Address: _____	Method of Lat/Long (circle one): Conventional Survey, <u>27</u>
<u>49 Roy Road</u>	USGS quad, <u>Hand-held GPS</u> Survey-grade GPS
<u>Lumberton MS 39455</u>	_____ 1/4 _____ 1/4 Sec <u>27</u> Twn <u>15</u> Rng <u>14W</u>
City State Zip Code	Distance Direction Nearest Town
Telephone No. ( <u>601</u> ) <u>796-8047</u>	<u>6</u> Miles <u>SE</u> of <u>Lumberton</u>

Well Data

Purpose of Well (circle one) Home Industrial Public Supply Irrigation Fish Culture Other: \_\_\_\_\_

Date well drilling started: 11-28-05 Date well drilling completed: 11-28-05

If flowing, method of flow regulation: Valve \_\_\_\_\_ Other (describe) \_\_\_\_\_

Static Water Level: 22 feet above or below (circle one) land surface Date measured: 11-28-05

Method of Measurement (circle one) steel tape electric tape air line other: \_\_\_\_\_

Hole depth: 71 Well depth: 71 Well grouted to a depth of 12 feet

Type of grout (circle one): Cement Bentonite Mix

Casing length: 61 feet Casing diameter: 2 inches Type of casing: PVC SCH 40

Screen length: 10 feet Screen diameter: 2 inches Type of screen: WOP PVC

Screen slot size: .006 inches Setting depth: From 61 feet to 71 feet

Type of completion (circle all applicable): Gravel packed Underreamed Telescoped Open hole Natural Development

Other (describe): \_\_\_\_\_

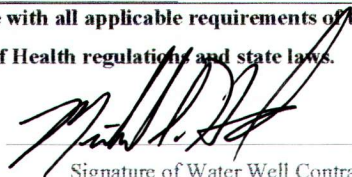
Top of lap pipe or reduction in casing: \_\_\_\_\_ feet. If telescoped or more than one screen, describe on back of page

Logs run (circle all applicable): No log run Electric Gamma Ray Density Sonic Neutron Other: \_\_\_\_\_

Name of organization running log(s): \_\_\_\_\_

I certify that the well was drilled, constructed, and completed in accordance with all applicable requirements of the Mississippi Department of Environmental Quality and/or the Mississippi Department of Health regulations and state laws.

Michael S. Harold ~~0-673~~ 0-673  
Print Name of Water Well Contractor and License No.

  
Signature of Water Well Contractor

RECEIVED  
JAN 03 2006  
BY: OLWR





# STATE WELL REPORT

## Part 2

**Pump Installer's Completion Report**  
 Mississippi Department of Environmental Quality  
 Office of Land and Water Resources  
 P.O. Box 10631  
 Jackson, MS 39289-0631  
 (601)961-5210  
 (601)354-6938 (fax)

County: Pearl River  
 Permit #:  
 Driller: Michael S. Havard  
 Date completed: 11-28-05

For Office Use Only:

Aquifer:  
 Well #: D-92  
 Elevation:

**This report should be prepared by the pump installer in detail and filed with the Department within 30 days of the installation of pump.**

Well Owner Information	Well Location
Owner Name: <u>Meru. Kritzman</u>	Latitude: <u>30 56 01</u> Longitude: <u>89 23 27</u>
Mailing Address: <u>49 Roy Road</u> <u>Lumberton MS 39455</u> City State Zip Code	Method of Lat/Long (circle one): Conventional Survey, USGS quad, Hand-held GPS, Survey-grade GPS <u>1/4 1/4 Sec 27 Twn 15 Rng 14w</u>
Telephone No. <u>(601) 796-8047</u>	Distance Direction Nearest Town <u>6</u> Miles <u>SE</u> of <u>Lumberton</u>

Pump Type Circle one	Power Type Circle one
Air Lift <input checked="" type="radio"/> Submersible	Diesel Engine Gasoline Engine Natural Gas
Bucket Piston Turbine	Electric Motor Hand Tractor PTO
Centrifugal Rotary Flowing Well	Windmill Other (specify):
Other (specify):	Horse Power Rating of Motor:
Date Pump Installed: <u>11-28-05</u>	Setting Depth: feet
Rated Pump Capacity: <u>10</u> Gallons Per Minute	Number of Stages:

Pump Test Data	Method of Measuring Water Level Circle one
Date Well Tested: <u>11-28-05</u>	<input checked="" type="radio"/> Air Line Electric Measuring Line Steel Tape
Static Water Level (A): <u>22</u> Feet Below Land Surface	Other (specify):
Pumping Water Level (B): <u>30</u> Feet Below Land Surface	For flowing well, measured shut in head: feet
Drawdown [(B) - (A)]: <u>8</u> Feet Below Land Surface	Well yielded <u>10</u> GPM with a drawdown of
Test Pumping Rate: <u>10</u> Gallons Per Minute	<u>8</u> feet after <u>4</u> hours of pumping
Duration of Pump Test (minimum 4 hours): <u>4</u> hours	

I HEREBY CERTIFY that the above statements are true to the best of my knowledge.

Michael S. Havard 0-673 [Signature]  
 Print Name of Pump Installer and License No. (if applicable) Signature of Pump Installer

RECEIVED  
 JAN 03 2006  
 BY: OLWR