

Pearl R.
D 2001
7/1/77

MISSISSIPPI
BOARD OF WATER COMMISSIONERS
416 North State Street
Jackson, Mississippi 39201

WATER WELL DRILLERS LOG

7-1 1977 Bud Benton Pearl River
date well completed firm name county well located

LANDOWNER:
Wayne Hall
Lumberton, Ms
(mailing address)

description of formations encountered	from	to
Red Shale	0	40
Red sand	40	65
Blue shale	65	250
Grey sand	250	265

WELL LOCATION:
sec. 23 T. 1 N. R. 14 E.
8 miles S E of Lumberton
(distance) (direction) (nearest town)


WELL PURPOSE: Home
(home, irrigation, municipal, industrial)

- WELL COMPLETION DATA:
- (1) diameter (inches) 4 in
 - (2) total depth (feet) 265
 - (3) static water level (feet) 122 below top of ground.
 - (4) casing PVC 255 (material) (depth)
 - (size) If telescope see back.
 - (5) screen 2x10 255 (length) (depth to top)
 - 12 PVC (size) (material)
 - (6) pump 1 650 (HP) (yield gpm)
 - electric 119 gpm (type power)
 - (7) electric log NO (yes or no)

(organization running log)

(8) how well bottom plugged
Sand Shale


DRILLERS REMARKS:

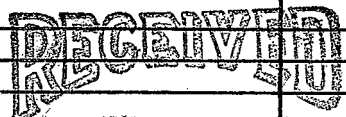

DEC 30 1977

If well telescopes please sketch and show depths.

GROUND LEVEL

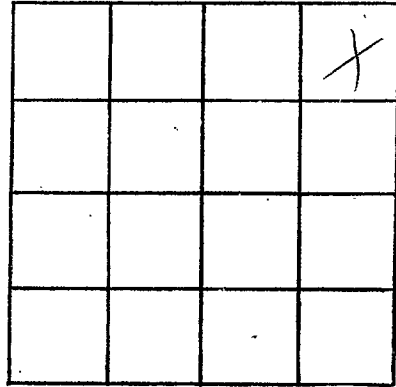

SECTION _____

Please indicate well location X.

ADDITIONAL INFORMATION

A series of horizontal lines for writing additional information, starting below the 'ADDITIONAL INFORMATION' header and extending to the bottom of the page.

If more than one screen, show locations of each on sketch.