

Pearl R.
D2002
10/24/77

MISSISSIPPI
BOARD OF WATER COMMISSIONERS
416 North State Street
Jackson, Mississippi 39201

WATER WELL DRILLERS LOG

Pearl River

10/24 1977 date well completed
Hollinsworth Well Service firm name
Pearl River county well located

LANDOWNER: James Terrell
RT 3
Lumberton, MS
(mailing address)

description of formations encountered	from	to
	clay sand gravel	0
	55	65

WELL LOCATION:
sec. 22-T 1 N R 14 E
5 1/2 miles S of Lumberton
(distance) (direction) (nearest town)

WELL PURPOSE: Home
(home, irrigation, municipal, industrial)

- WELL COMPLETION DATA:
- (1) diameter (inches) 4"
 - (2) total depth (feet) 75
 - (3) static water level (feet) 40 below above top of ground.
 - (4) casing PVC 65
(material) (depth)
(size) If telescope see back.
 - (5) screen 10 65
(length) (depth to top)
4" PVC
(size) (material)
 - (6) pump 1 18
(HP) (yield gpm)
elect
(type power)
 - (7) electric log _____
(yes or no)

(organization running log)
(8) how well bottom plugged sand spark

DRILLERS REMARKS: good well


RECEIVED

NOV 30 1977

MISS. BD. OF WATER COMM

If well telescopes please sketch and show depths.

GROUND LEVEL

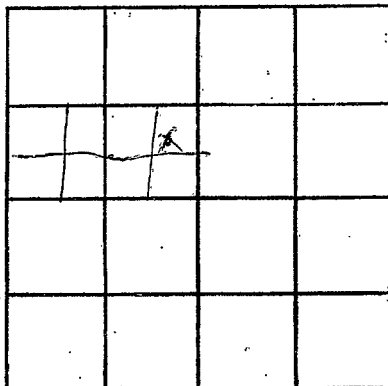

SECTION 22

Please indicate well location X.

ADDITIONAL INFORMATION

If more than one screen,
show locations of each on sketch.