

PEARL RIVER

D2003

11-29-78

MISSISSIPPI BOARD OF WATER COMMISSIONERS

416 North State Street

Jackson, Mississippi 39201

Pearl River

WATER WELL DRILLERS LOG

TOM GRIFFITH

PLUMBING & WELL SERVICE, INC.

320 MAYSON AVE.

COLUMBIA, MS 39428

county well located

LANDOWNER:

Vera Haroldson

Rt. 3 Box 6 Lumberton (mailing address) Miss.

WELL LOCATION:

sec 36 T 1 N R 14 E

9 miles (distance) S E of Lumberton (direction) (nearest town)

WELL PURPOSE:

(home, irrigation, municipal, industrial)

WELL COMPLETION DATA:

- (1) diameter (inches) 4"
- (2) total depth (feet) 85 ft.
- (3) static water level (feet) 45 ft below top of ground.
- (4) casing plastic 65 ft (material) (depth) 4" (size) If telescope see back.
- (5) screen 20 ft, 65 ft (length) (depth to top) 4" (size) plastic (material)
- (6) pump 1/2 hp 10 (HP) (yield gpm) Electric (type power)
- (7) electric log NO (yes or no)

(organization running log)

(8) how well bottom plugged Rock Wash Valve

DRILLERS REMARKS:

description of formations encountered

from to


Top Soil	0	1
Clay	1	6
Sand & Gravel	16	18
Clay	18	37
Sand & Gravel	51	74
Sand	71	85

RECEIVED FEB - 1 1978

MISS. BD. OF WATER COMM.

If well telescopes please sketch and show depths.

GROUND LEVEL

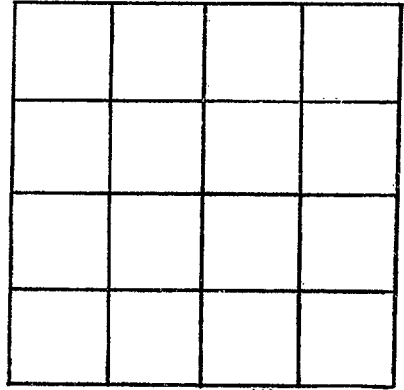

SECTION \_\_\_\_\_

Please indicate well location X.

ADDITIONAL INFORMATION

If more than one screen,  
show locations of each on sketch.