

PEARL RIVER
D 2004
5-10-79

MISSISSIPPI
BOARD OF WATER COMMISSIONERS
 416 North State Street
 Jackson, Mississippi 39201

WATER WELL DRILLERS LOG

May 10, 1979 Divie Water Well & Pump, Inc. (Pearl River)
 date well completed firm name county well located

LANDOWNER: Mr. Joe LaBella
Belle Chase, La.

description of formations encountered	from	to
<u>Sandy Clay</u>	<u>0</u>	<u>8</u>
<u>Sand & Gravel (Red)</u>	<u>8</u>	<u>50</u>
<u>White Sand</u>	<u>50</u>	<u>88</u>

(mailing address)

WELL LOCATION:

sec. 27 T 1 N S R 14 E W

_____ miles _____ of _____
 (distance) (direction) (nearest town)

WELL PURPOSE: Home
 (home, irrigation, municipal, industrial)

WELL COMPLETION DATA:

- (1) diameter (inches) 2"
- (2) total depth (feet) 88'
- (3) static water level (feet) 18' below top of ground.
- (4) casing P.V.C. 78'
 (material) (depth)
2" If telescope see back.
 (size)
- (5) screen 10' 78'
 (length) (depth to top)
2" P.V.C.
 (size) (material)
- (6) pump 1 10
 (HP) (yield gpm)
Electric
 (type power)

Miss. Board of Water Comm.

JUN 21 1979

RECEIVED


(7) electric log no
 (yes or no)
 (organization running log)

(8) how well bottom plugged
shut down

DRILLERS REMARKS:

If well telescopes please sketch and show depths.

GROUND LEVEL

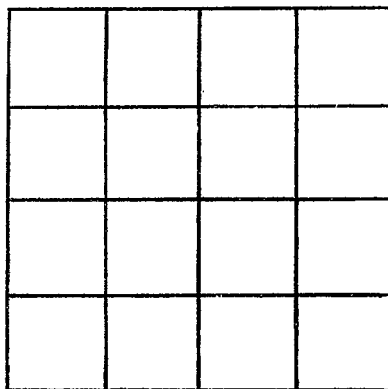

SECTION _____

Please indicate well location X.

ADDITIONAL INFORMATION

If more than one screen, indicate locations of each on sketch.