

MISSISSIPPI DEPARTMENT OF NATURAL RESOURCES
Bureau of Land and Water Resources
 Southport Mall
 P.O. Box 10631
 Jackson, Mississippi 39209
WATER WELL DRILLERS LOG

Paul River
D. 2008

Jan 24, 1982 date well completed *Cochran Brothers Drilling Service* firm name *Pearl River* county well located

LANDOWNER:
W. H. Jordan
Rt. 2 Columbia
 (mailing address)

WELL LOCATION:
 sec. 17 T. 1 N. R. 14 E.
5 miles S of Lumberton
 (distance) (direction) (nearest town)

WELL PURPOSE: None
 (~~home~~ irrigation, municipal, industrial)

WELL COMPLETION DATA:

- (1) diameter (inches) 2"
- (2) total depth (feet) 160'
- (3) static water level (feet) 61 ^{below} ~~above~~ top of ground.
- (4) casing PVC, 15.5'
 (material) (depth)
 _____ if telescope see back.
 (size)
- (5) screen 5', 155'
 (length) (depth to top)
2", PVC
 (size) (material)
- (6) pump 1, 6
 (HP) (yield gpm)
Elec.
 (type power)
- (7) electric log no
 (yes or no)


 (organization running log)
- (8) how well bottom plugged value

description of formations encountered	depth	
	from	to
<i>Top Soil</i>	<i>0</i>	<i>1</i>
<i>Brown clay</i>	<i>1</i>	<i>3</i>
<i>Red clay</i>	<i>3</i>	<i>8</i>
<i>Gray clay</i>	<i>8</i>	<i>21</i>
<i>Sand</i>	<i>21</i>	<i>29</i>
<i>Blue clay</i>	<i>29</i>	<i>82</i>
<i>fine sand</i>	<i>82</i>	<i>130</i>
<i>Sand + Gravel</i>	<i>130</i>	<i>160</i>

DRILLERS REMARKS:

If well telescopes please sketch and show depths.

GROUND LEVEL

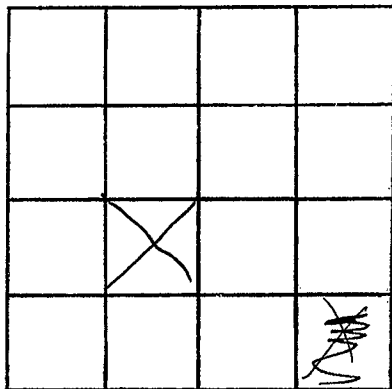

SECTION

~~17~~ 17

Please indicate well location X.

ADDITIONAL INFORMATION

If more than one screen,
show locations of each on sketch.