

Pearl River
D2009

MISSISSIPPI
 BOARD OF WATER COMMISSIONERS
 416 North State Street
 Jackson, Mississippi 39201

WATER WELL DRILLERS LOG

April 27 1982 Parness Anderson Pearl River
 date well completed firm name county well located

LANDOWNER: Donal Howard

description of formations encountered

from to

Paplarville, Ms
 (mailing address)

<u>Top soil</u>	<u>0</u>	<u>4</u>
<u>Clay sand</u>	<u>4</u>	<u>28</u>
<u>Clay</u>	<u>28</u>	<u>44</u>
<u>Coarse sand</u>	<u>44</u>	<u>60</u>

WELL LOCATION:

sec 25 T 1 N S R 14 W
14 miles NE of Paplarville
 (distance) (direction) (nearest town)

WELL PURPOSE: Home
 (home, irrigation, municipal, industrial)

WELL COMPLETION DATA:

- (1) diameter (inches) 2"
- (2) total depth (feet) 60'
- (3) static water level (feet) 53 below top of ground.
- (4) casing PVC
 (material) (depth)

 if telescope see back.
 (size)

- (5) screen 5 55'
 (length) (depth to top)

2" PVC
 (size) (material)

- (6) pump 1 10
 (HP) (yield gpm)

Electric
 (type power)

- (7) electric log NO
 (yes or no)

 (organization running log)

- (8) how well bottom plugged Capped

DRILLERS REMARKS:


DEPT. OF NATURAL RESOURCES
 BUREAU OF LAND & WATER RESOURCES

JUN - 9 1982

RECEIVED

If well telescopes please sketch and show depths.

GROUND LEVEL

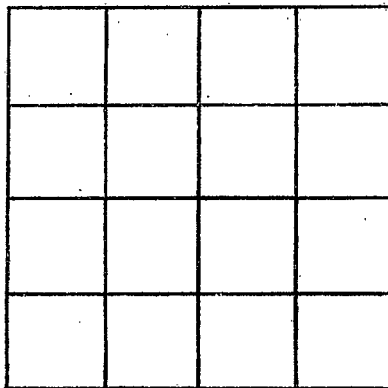

SECTION _____

Please indicate well location X.

ADDITIONAL INFORMATION

If more than one screen,
show locations of each on sketch.