

Paul River
D 2011

MISSISSIPPI DEPARTMENT OF NATURAL RESOURCES
Bureau of Land and Water Resources
Southport Mall
P.O. Box 10631

Jackson, Mississippi 39209
WATER WELL DRILLERS LOG

3-21
date well completed

83 Frank Price Paul River
firm name county well located


LANDOWNER:	description of formations encountered	from	to
Maurice Cameron	Top Soil	0	2
(mailing address)	Sandy Clay	2	25
WELL LOCATION:	Coarse Sand	15	65
sec. 1 T 1 S R 14 W			
6 miles E Glenbeaten			
(distance) (direction) (nearest town)			
WELL PURPOSE: HOME			
(home, irrigation, municipal, industrial)			
WELL COMPLETION DATA:			
(1) diameter (inches) 2"			
(2) total depth (feet) 65'			
(3) static water level (feet) 32' below top of ground.			
(4) casing Plastic, 60'			
(material) (depth)			
(size) if telescope see back.			
(5) screen 5' , 60'			
(length) (depth to top)			
2" Plastic			
(size) (material)			
(6) pump 1 HP 11 (yield gpm)			
Elect (type power)			
(7) electric log no (yes or no)			
(organization running log)			
(8) how well bottom plugged capped			
DRILLERS REMARKS:			

APR 18 1983

RECEIVED

If well telescopes please sketch and show depths.

GROUND LEVEL

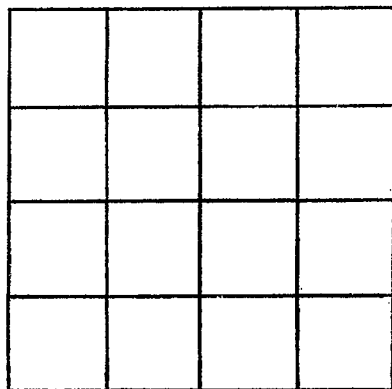

SECTION _____

Please indicate well location X.

ADDITIONAL INFORMATION

If more than one screen,
show locations of each on sketch.