

MISSISSIPPI DEPARTMENT OF NATURAL RESOURCES

Bureau of Land and Water Resources

Southport Mall

P.O. Box 10631

Jackson, Mississippi 39209

WATER WELL DRILLERS LOG

Paul River  
D 2012

7-28 1983 Frank Price Paul River  
 date well completed firm name county well located

LANDOWNER:	description of formations encountered	from	to
<u>Pat Morrison</u>	<u>Top Soil</u>	<u>0</u>	<u>3</u>
(mailing address)	<u>white clay</u>	<u>3</u>	<u>195</u>
WELL LOCATION:	<u>Coarse Sand</u>	<u>195</u>	<u>210</u>
sec. <u>19</u> T. <u>1</u> N. <u>3</u> S. R. <u>14</u> E. <u>Beam</u>			
<u>3</u> miles <u>N</u> of <u>Paul River</u>			
(distance) (direction) (nearest town)			
WELL PURPOSE: <u>HOME</u>			
(home, irrigation, municipal, industrial)			
WELL COMPLETION DATA:			
(1) diameter (inches) <u>2"</u>			
(2) total depth (feet) <u>210'</u>			
(3) static water level (feet) <u>50'</u> below top of ground.			
(4) casing <u>Plastic, 205'</u>			
(material) (depth)			
(size) if telescope see back.			
(5) screen <u>5'</u> , <u>265'</u>			
(length) (depth to top)			
<u>2"</u> , <u>Plastic</u>			
(size) (material)			
(6) pump <u>1</u> <u>6</u>			
(HP) (yield gpm)			
<u>Elect</u>			
(type power)			
(7) electric log <u>no</u>			
(yes or no)			
(organization running log)			
(8) <u>no</u> well bottom plugged			
<u>D.W.V.</u>			
DRILLERS REMARKS:			


DEPT. OF NATURAL RESOURCES  
 BUREAU OF LAND & WATER RESOURCES

SEP 12 1983

RECEIVED

If well telescopes please sketch and show depths.

GROUND LEVEL

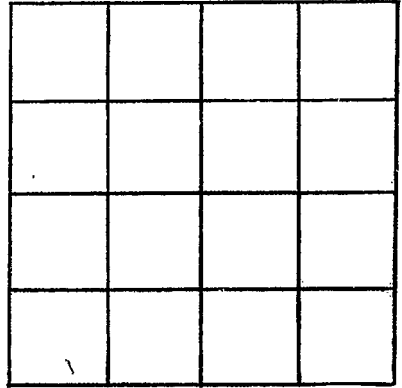

SECTION \_\_\_\_\_

Please indicate well location X.

ADDITIONAL INFORMATION

If more than one screen,  
show locations of each on sketch.