

MISSISSIPPI DEPARTMENT OF NATURAL RESOURCES

Bureau of Land and Water Resources

Southport Mall

P.O. Box 10631

Jackson, Mississippi 39209

WATER WELL DRILLERS LOG

Paul River  
D 2015

3-27-84 19 Walker Welding Paul River  
date well completed firm name county well located

LANDOWNER: <u>Guy N. Smith</u>	description of formations encountered		from	to
<u>picayune miss</u>	<u>Red sand</u>		<u>0</u>	<u>12</u>
(mailing address)	<u>Clay</u>			
WELL LOCATION:	<u>sand</u>		<u>12</u>	<u>54</u>
sec. <u>10</u> T. <u>1</u> S. R. <u>14</u> W.				
<u>4</u> miles <u>E</u> of <u>Summit</u>				
(distance) (direction) (nearest town)				
WELL PURPOSE: <u>Home</u>				
(home, irrigation, municipal, industrial)				
WELL COMPLETION DATA:				
(1) diameter (inches) <u>4"</u>				
(2) total depth (feet) <u>54'</u>				
(3) static water level (feet) <u>10</u> below top of ground.				
(4) casing <u>PVC</u> , <u>44'</u> (material) (depth)				
(size) if telescope see back.				
(5) screen <u>10'</u> , <u>44'</u> (length) (depth to top)				
<u>10</u> (size) <u>PVC</u> (material)				
(6) pump <u>1/2</u> (HP) <u>12</u> (yield gpm)				
<u>Elec</u> (type power)				
(7) electric log (yes or no)				
(organization running log)				
(8) how well bottom plugged <u>sand</u>				
<u>shock</u>				
DRILLERS REMARKS:				


DEPT. OF NATURAL RESOURCES  
BUREAU OF LAND & WATER RESOURCES

APR 11 1984

RECEIVED

If well telescopes please sketch and show depths.

GROUND LEVEL

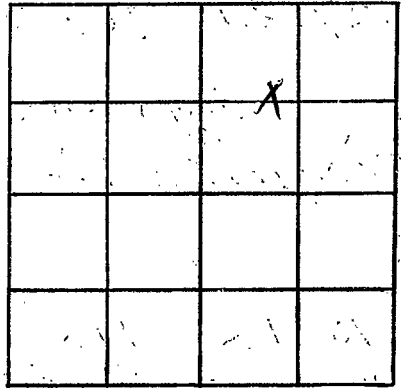

SECTION \_\_\_\_\_

Please indicate well location X.

ADDITIONAL INFORMATION

If more than one screen,  
show locations of each on sketch.